


From Submittal 152.1
All SMPs at Location 19 complete by end of PP16 - March 2022;
44.44% LS charged in previous Payments.

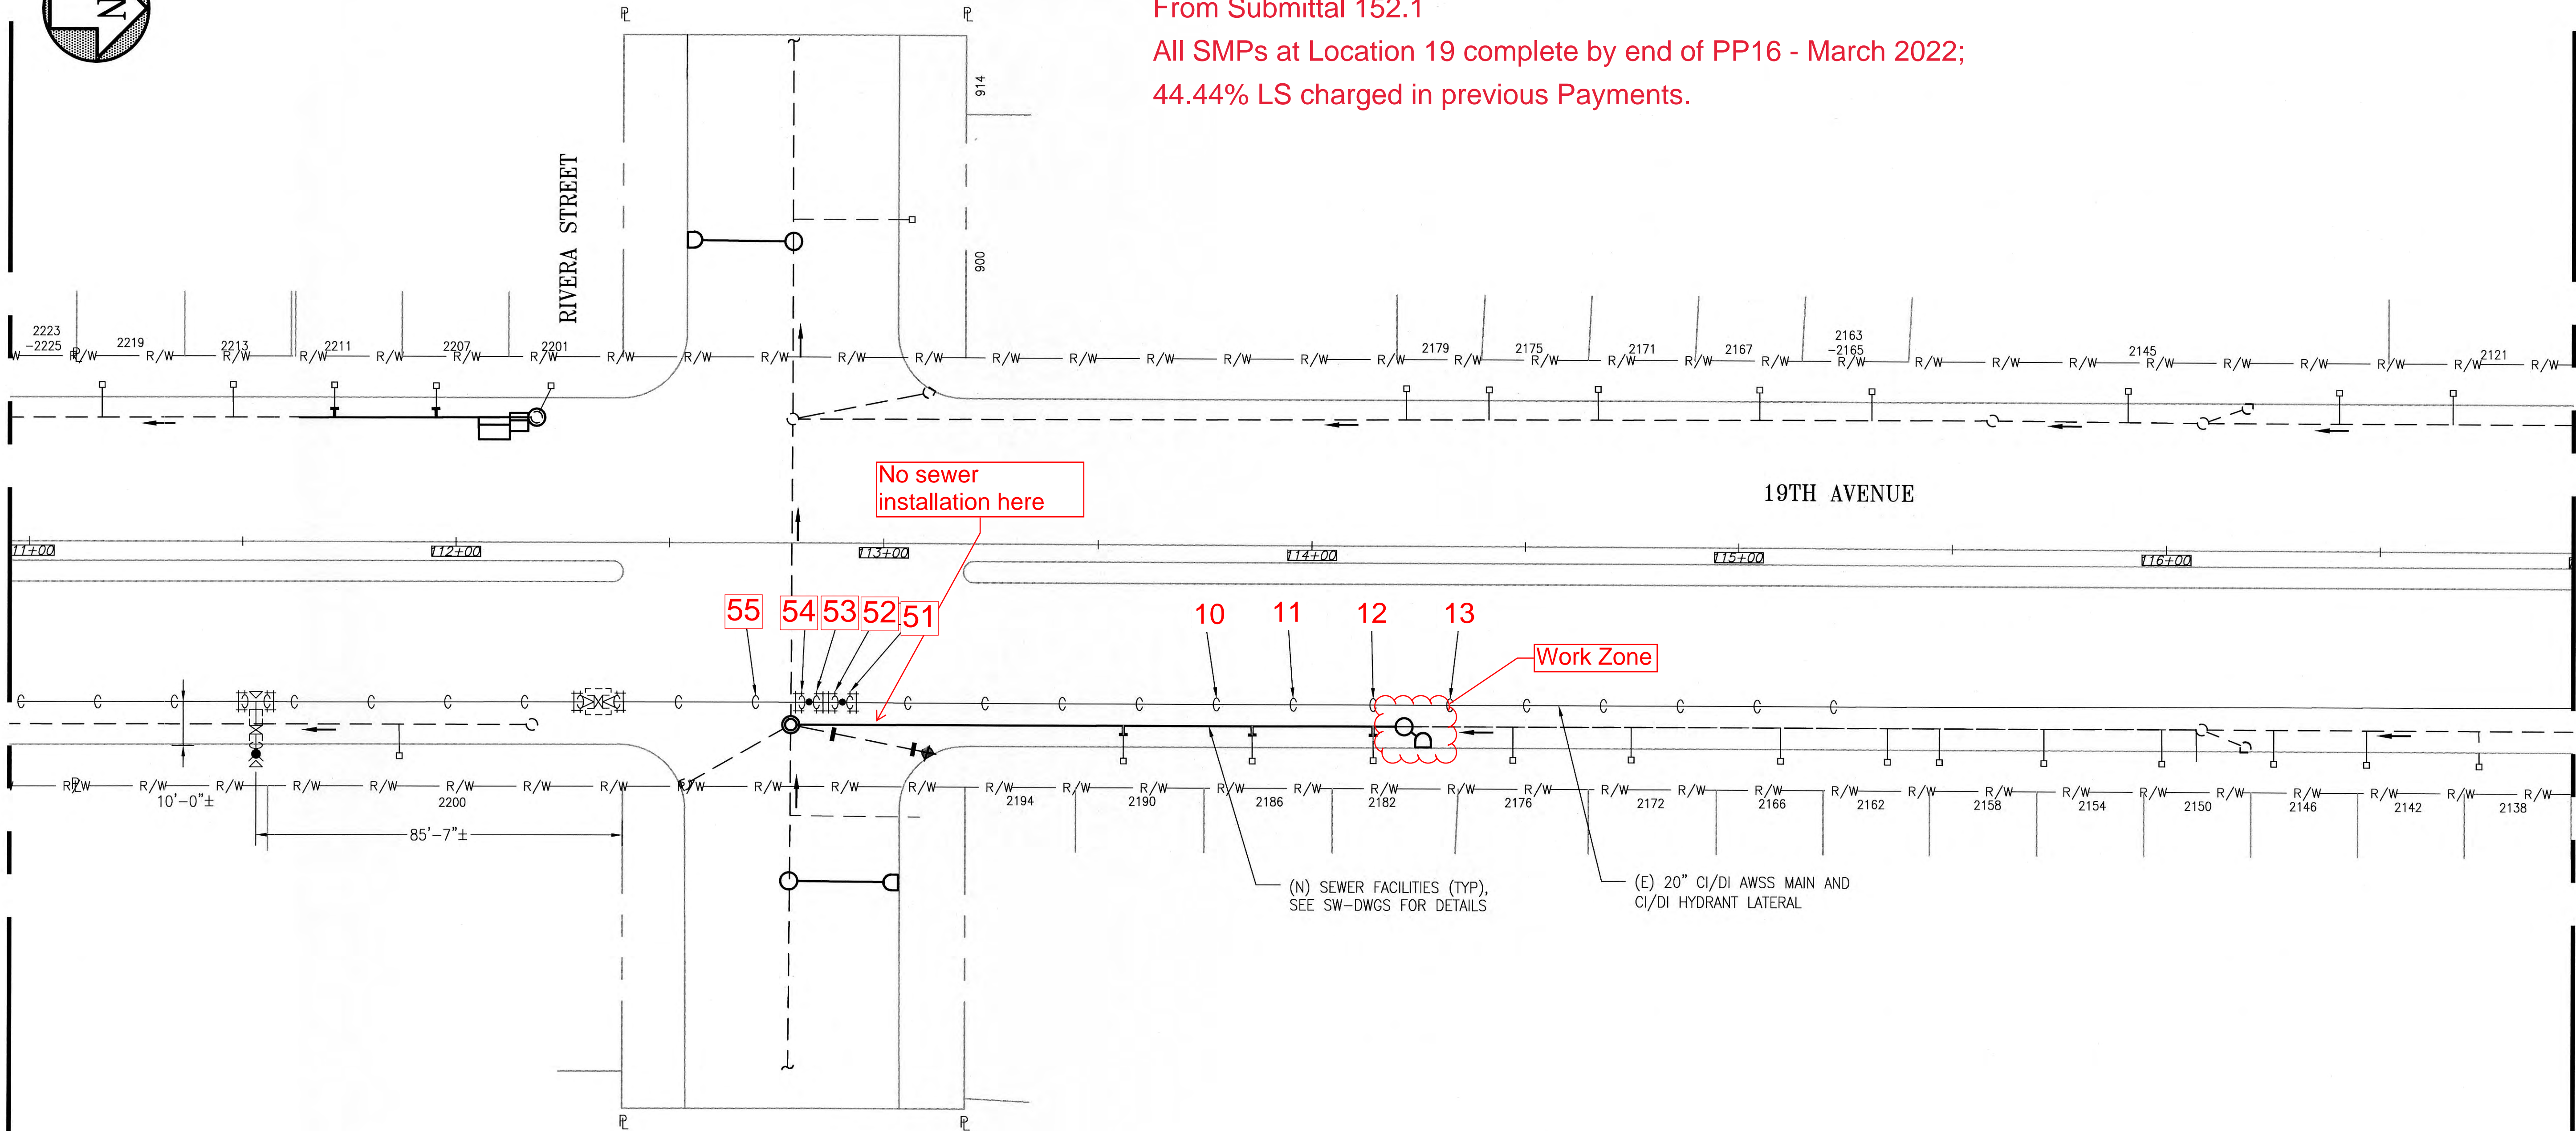


NOTES:

- REFER TO DWG MA-G06 FOR SETTLEMENT MONITORING AND SUPPORT OF (E) AWSS FACILITIES AS REQUIRED DUE TO ADJACENT/BELOW EXCAVATION WORK FOR OTHER UTILITIES/STRUCTURES.
- THE CONTRACTOR SHALL FIELD VERIFY THE EXACT DEPTHS AND LOCATIONS OF AWSS PIPES.
- REFER TO RELATED DWGS IN THIS CONTRACT PACKAGE FOR EXISTING UTILITIES ADJACENT TO THE AWSS FACILITIES TO BE REMOVED.
- REFER TO DWGS MA-G02 AND MA-G05 FOR NOTIFICATION, SCHEDULING AND SEQUENCING OF WORK.
- EXISTING PIPELINE ELEVATION FROM FINISHED STREET GRADE TO CENTERLINE OF PIPE PER RECORD DWGS AS PROVIDED BY THE SFPUC:
-20" DI PIPE ON 19TH AVENUE AT RIVERA STREET: 5'-0"± TO 6'-1"±

SETTLEMENT MONITORING WORK - PLAN
SCALE: 1"=20'-0"

LOCATION 19 - 19TH AVENUE AND RIVERA STREET

PLOT: EXTENTS
SCALE: 1:1
BORDER:
22.34
COLOR: No.
RED 0.70MM
YELLOW 0.20MM
GREEN 0.25MM
CYAN 0.40MM
BLUE 0.50MM
MAGENTA 0.20MM
WHITE 0.35MM
GRAY 0.15MM
9 0.15MM
10 1.00MM
100 0.50MM
210 0.50MM

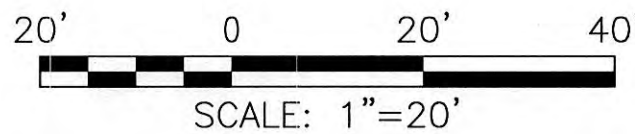

FOR THE SOLE USE OF THE DOCUMENT
RECIPIENT - DO NOT CITE, COPY, OR
CIRCULATE WITHOUT THE EXPRESS
PERMISSION OF THE SFPUC.

REFERENCES
GATE BOOK PAGES, PLANS,
SURVEY NOTES, ETC, USED
GATE BOOK PAGES
NO.
AWSS DWG NOS. 836,
837



CITY AND COUNTY OF SAN FRANCISCO SAN FRANCISCO PUBLIC WORKS BUREAU OF DESIGN AND ENGINEERING			
SECTION MANAGER	12/17/18	DRAWN	MM/WC 01/2019
DEPUTY BUREAU MANAGER	12/19/18	DESIGNED	MBS 01/2019
BUREAU MANAGER	12/21/18	CHECKED	EL 01/2019
NO.	DATE	DESCRIPTION	BY APPR'D
REVISIONS			

CITY AND COUNTY OF SAN FRANCISCO PUBLIC UTILITIES COMMISSION WATER ENTERPRISE CITY DISTRIBUTION DIVISION 19TH AVENUE (STATE ROUTE 1) COMBINED CITY PROJECT			
AUXILIARY WATER SUPPLY SYSTEM WORK LOCATION 19 - SETTLEMENT MONITORING PLAN			
APPROVED <i>[Signature]</i> ENGINEERING MANAGER	APPROVED <i>[Signature]</i> MANAGER, CITY DISTRIBUTION DIVISION	SCALE 1"=20'-0"	DATE 01/2019
SHEET 253 OF 356	PLAN NO. MA-19.4	FILE NO. 111,551	REVISION NO. 0