

AS-BUILT
08/17/23
JOB# 2020-12


Asphalt 2" = 660+26
Total = 686 SF

Striping = 46 + 96
Total = 142 LF

LINE TABLE		
LINE #	LENGTH	BEARING
L1	9.67	S87° 52' 29.24"W
L2	5.05	S87° 52' 29.24"W
L3	84.00	N1° 57' 48.63"W
L4	5.93	N1° 57' 48.63"W
L5	7.83	N0° 05' 24.25"E
L6	70.21	N1° 58' 12.49"W
L7	7.51	S88° 11' 32.02"W
L8	5.29	S88° 11' 32.02"W

CURVE TABLE					
CURVE #	LENGTH	RADIUS	TAN	DELTA	CHORD
C1	12.87	20.00	6.67	36°52'12"	12.65
C2	6.44	10.00	3.33	36°52'12"	6.32
C3	23.60	15.00	15.04	90°09'42"	21.24
C4	6.15	10.00	3.18	35°14'51"	6.06
C5	12.30	20.00	6.35	35°14'51"	12.11
C6	12.30	20.00	6.35	35°14'51"	12.11
C7	6.15	10.00	3.18	35°14'51"	6.06
C8	23.52	15.00	14.96	89°50'15"	21.18
C9	6.43	10.00	3.33	36°52'10"	6.32
C10	12.87	20.00	6.67	36°52'10"	12.65

CORNER AC = 25 SF

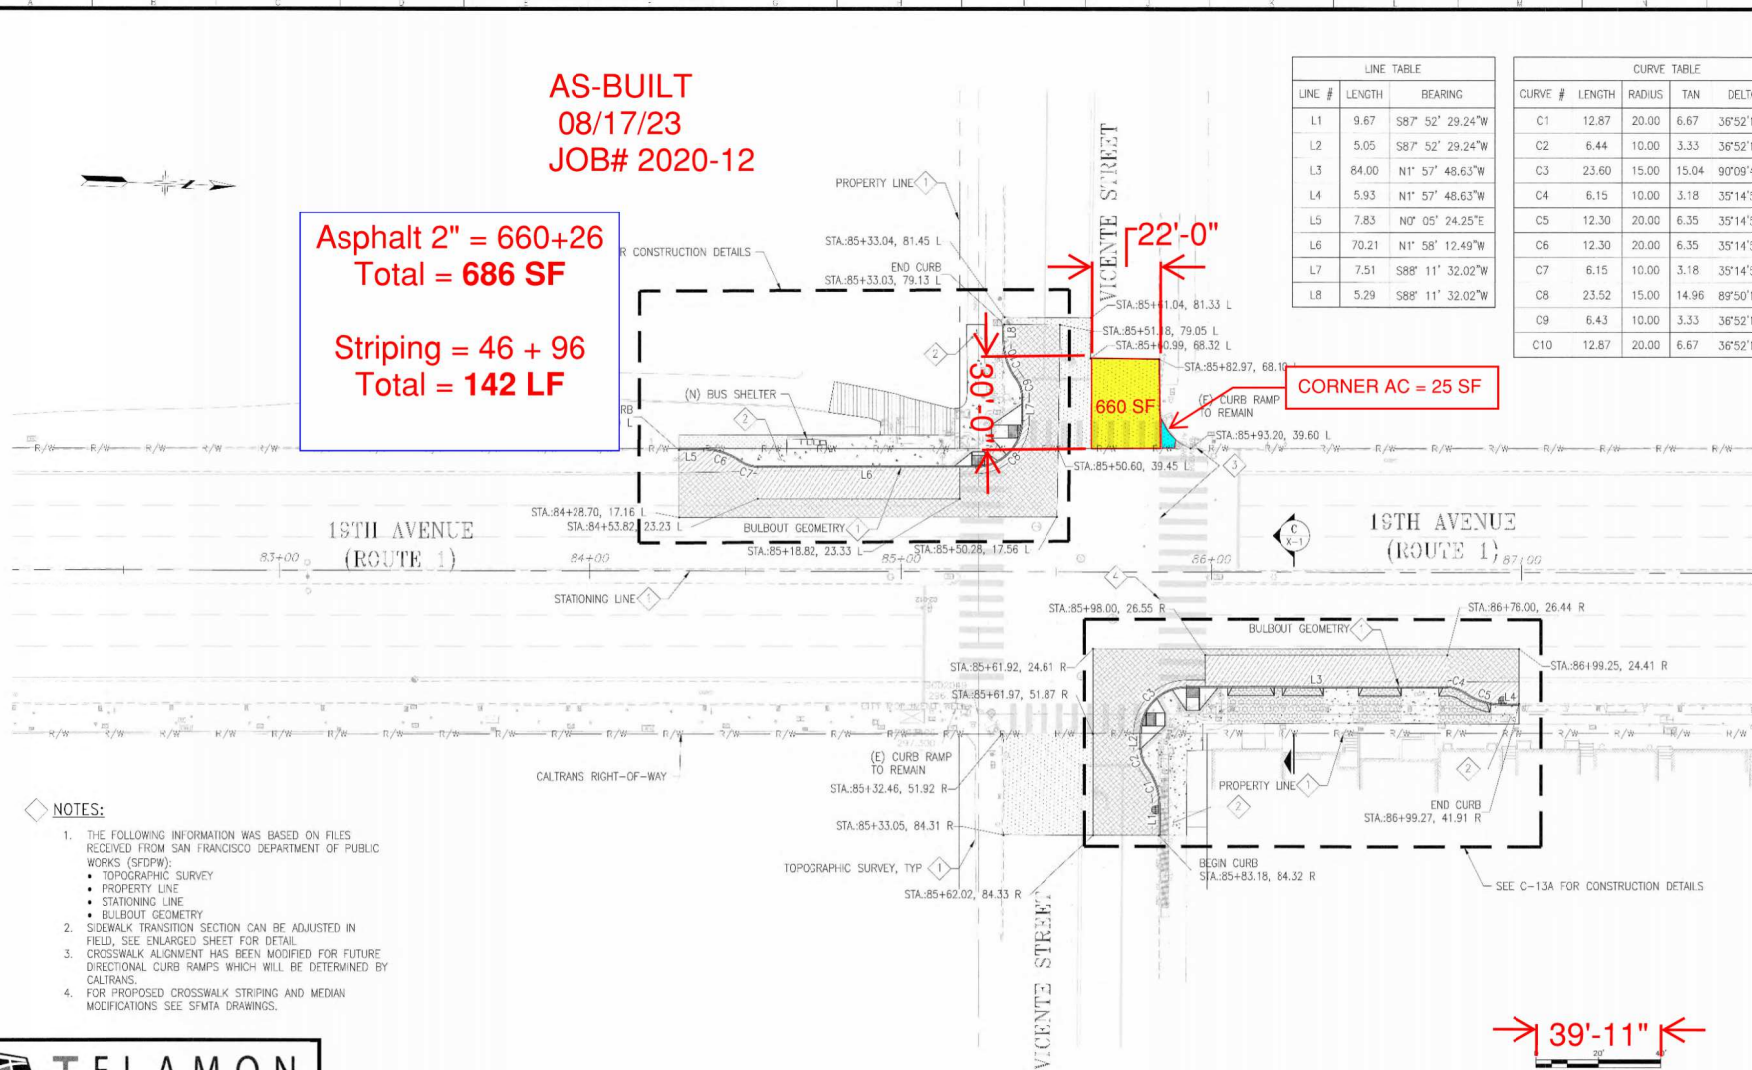


NOTES:

1. THE FOLLOWING INFORMATION WAS BASED ON FILES RECEIVED FROM SAN FRANCISCO DEPARTMENT OF PUBLIC WORKS (SFPD):
 - TOPOGRAPHIC SURVEY
 - PROPERTY LINE
 - STATIONING LINE
 - BULBOUT GEOMETRY
2. SIDEWALK TRANSITION SECTION CAN BE ADJUSTED IN FIELD. SEE ENLARGED SHEET FOR DETAIL.
3. CROSSWALK ALIGNMENT HAS BEEN MODIFIED FOR FUTURE DIRECTIONAL CURB RAMP WHICH WILL BE DETERMINED BY CALTRANS.
4. FOR PROPOSED CROSSWALK STRIPING AND MEDIAN MODIFICATIONS SEE SFMTA DRAWINGS.

TELAMON
ENGINEERING CONSULTANTS, INC.
855 FOLSOM STREET, SUITE 142
SAN FRANCISCO, CA 94107
TEL: 415-837-1336 FAX: 415-837-1354

NO.	DATE	DESCRIPTION	BY	APP.
TABLE OF REVISIONS				
H'S DRAWING WAS LAST UPDATED: 12/11/19 16:00:00 BY: [Signature]				

REVISION INFORMATION & FILE NO. OF SURVEYS

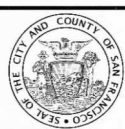

BUREAU OF ENGINEERING
CITY & COUNTY OF SAN FRANCISCO
SAN FRANCISCO PUBLIC WORKS
30 VAN NESS AVENUE, 5TH FLOOR
SAN FRANCISCO, CA 94102 - 6028

Acting Section Manager <i>Eric Killebrew</i> Deputy Bureau Manager <i>Fernando Cisneros</i> Acting Bureau Manager <i>Iqbal Chappa</i>	Date 12/15/19 12/16/19 12/16/19
--	--

W/C BY: DZ DRAWN: JMT KN CHKD: MC	DATE: 12/19 12/19 12/19
--	-------------------------------

PLAN APPROVAL DATE	CONTRACT No.	PROJECT ID	DISTRICT	COUNTY	ROUTE	POST MILES TOTAL PROJECT
	04-0G3501	0400000325	04	SF	1	RG.94/4.05
SCALE 1" = 20'	19TH AVENUE (STATE ROUTE 1) COMBINED CITY PROJECT				DRAWING NO. L-13	
SHEET OF SHEETS 17 OF 356	19TH AVENUE AND VICENTE STREET LAYOUT PLAN				FILE NO. 111,314	
					REV. NO.	

Drawn: [Signature] 19th Avenue (State Route 1) and Vicente Street Layout Plan
Checked: [Signature] 11/16/19 11:00:00 BY: [Signature]
Scale: 1" = 20'
Drawing No: L-13
File No: 111,314
Rev. No: