


TRAFFIC CONTROL PLAN
19TH AVE (STATE ROUTE 1) COMBINED CITY PROJECT
SEWER WORK - 19TH AVE FROM WAWONA ST TO SLOAT BLVD

- ☐ NO EXCEPTIONS TAKEN
☒ MAKE CORRECTIONS NOTED
☐ REJECTED
☐ REVISE AND RESUBMIT
☐ SUBMIT SPECIFIED ITEM(S)

Review is only for general conformance with the design concept of the project and general compliance with the requirements of the contract documents. Any action shown is subject to the requirements of the plans and specifications. Contractor's responsibilities include, but are not limited to actual dimensions which shall be confirmed and correlated at the job site; preferred fabrication processes and techniques of construction; coordination of the contractor's work with that of all other trades; and the satisfactory performance of the contractor's work.


Sustainable Streets Division
 San Francisco Municipal Transportation Agency
 City and County of San Francisco

By: *[Signature]* Date: 4/18/2022

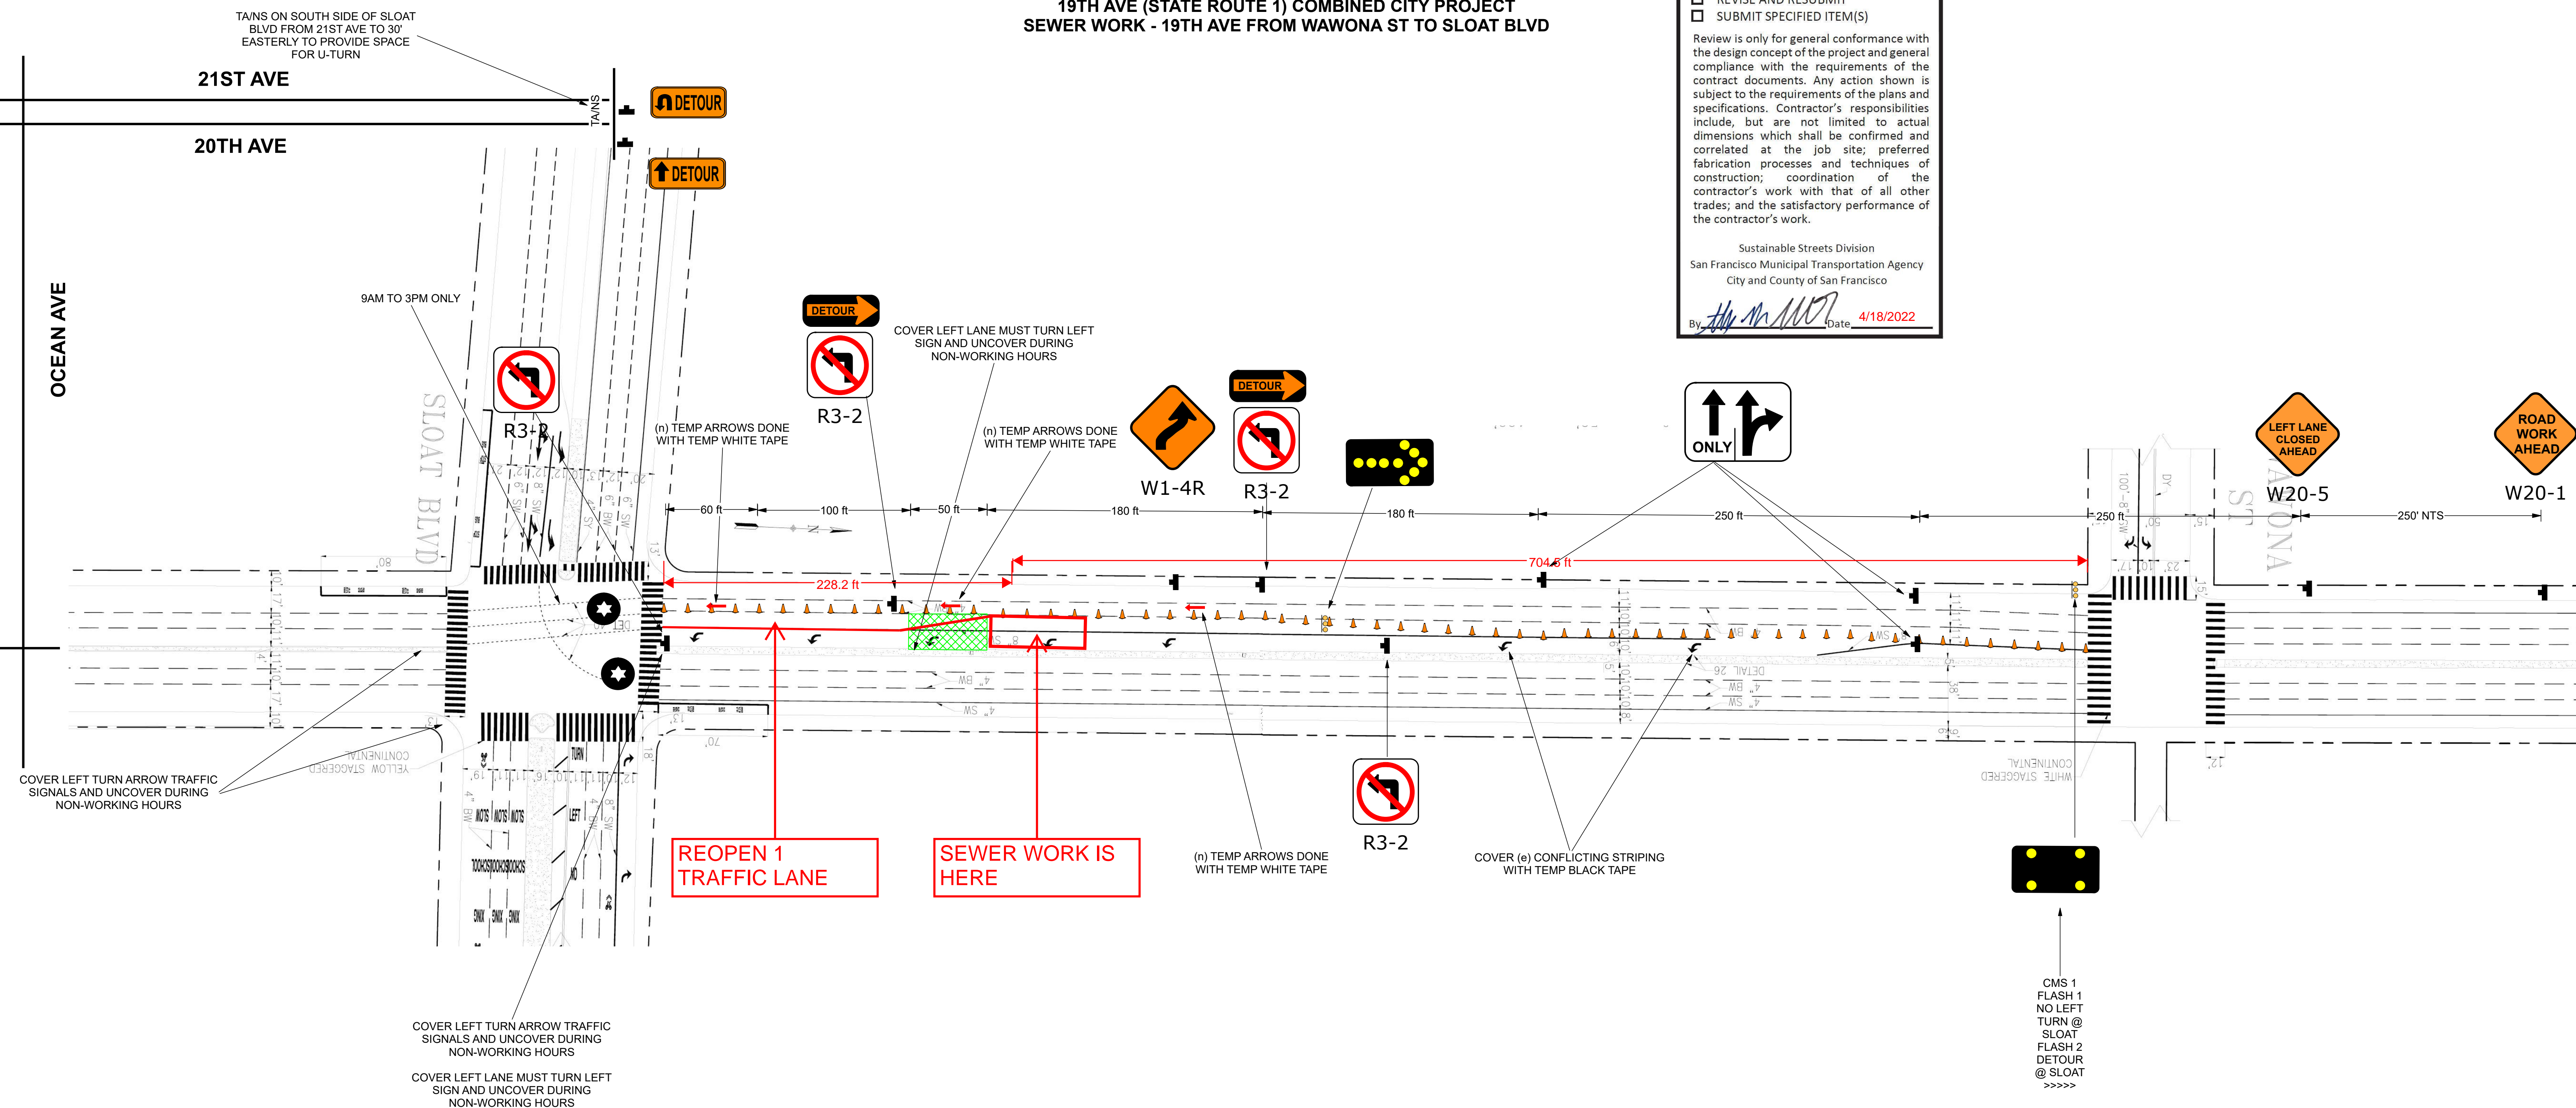

Legend	
	Type III Barricade
	28" Traffic Cone
	Delineator
	Pedestrian Barricade
	Work Area
	Sign and Stand
	Direction of Travel
NTS	Not To Scale
TAINs	Tow-Away/No Stopping
	Parking Control Officer
	Flagger
	Type I Barricade
	Flashing Beacon

STREET	TIME	NORTHBOUND	SOUTHBOUND	EASTBOUND	WESTBOUND
DURING SEWER WORK					
Sloat Ave. to Wawona St.	9AM - 3PM (M-F)	2@10'	2@10'	-	-
	Continuous during Sewer Lining Work	2@10'	2@10'	-	-
	At Other Times	Full Roadway	Full Roadway	-	-
Wawona St. to Vicente St.	7AM - 5PM (M-F)	2@10'	2@10'	-	-
	At Other Times	Full Roadway	Full Roadway	-	-
CROSS STREETS for 19TH AVENUE					
Sloat Blvd.	7AM - 5PM (M-F)	-	-	2@11'	3@10'
	At Other Times	-	-	Full Roadway	Full Roadway
Wawona St.	7AM - 5PM (M-F)	-	-	1 @ 10'	1@10'
	At Other Times	-	-	Full Roadway	Full Roadway
Vicente St.	7AM - 5PM (M-F)	-	-	1@10'	1@10'
	At Other Times	-	-	Full Roadway	Full Roadway

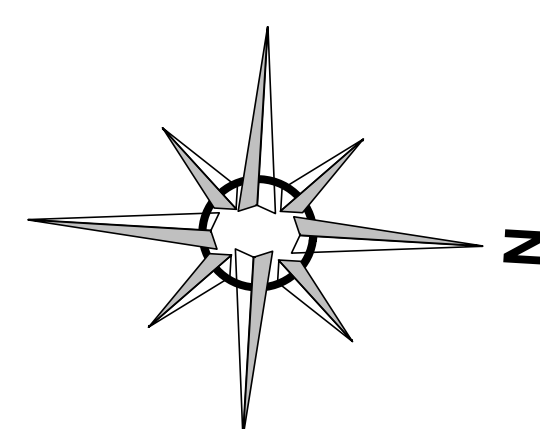

Plan Scale
 1" = 50'



3450 3RD ST #3G
 SAN FRANCISCO, CA 94124
 415-206-1700 PHONE
 415-206-1711 FAX
 INFO@CMCTRAFFIC.COM

LICENSE NO. 792059
 CLASS A, 31, C21
 WBE/SBE/LBE/DBE CERTIFIED
 WWW.CMCTRAFFIC.COM

Date: 04/06/2022 Author: RC/CM Project: 19TH AVE (STATE ROUTE 1) COMBINED CITY PROJECT
 Client: JMB CONSTRUCTION Location: SAN FRANCISCO TCP: 221
 CMC Job #: 2530

Comments:

- 1) WORK HOURS: SEE TRAFFIC LANE REQUIREMENTS TABLE
- 2) CONTRACTOR TO VERIFY EXISTING STRIPING IS ACCURATE PRIOR TO START OF WORK.
- 3) ALL TRAFFIC CONTROL SHALL CONFORM TO THE LATEST EDITION OF CA MUTCD.
- 4) ALL TRAFFIC CONTROL DEVICES SHALL BE RETROREFLECTIVE IF SETUP DURING HOURS OF DARKNESS.
- 5) MAINTAIN LOCAL ACCESS TO BUSINESSES AND RESIDENTS AT ALL TIME.
- 6) THE CONTRACTOR SHALL NOT PREVENT OR DELAY THE OPERATION OF MASS TRANSIT VEHICLES AT ANY TIME.
- 7) THE CONTRACTOR SHALL PERFORM THE APPROPRIATE MEASURES TO ENSURE THE SAFETY OF BICYCLISTS ON ALL STREET ON WHICH THERE IS CONSTRUCTION.
- 8) THE CONTRACTOR SHALL NOT WORK ON CURB RAMPS AT DIAGONALLY LOCATED CORNERS AT THE SAME TIME IF THERE IS SIDEWALK WORK OR UNLESS OTHERWISE INSTRUCTED BY THE TRAFFIC ENGINEER.