


TRAFFIC CONTROL PLAN
19TH AVE (STATE ROUTE 1) COMBINED CITY PROJECT
WATER WORK - 19TH AVE AT TARAVAL ST

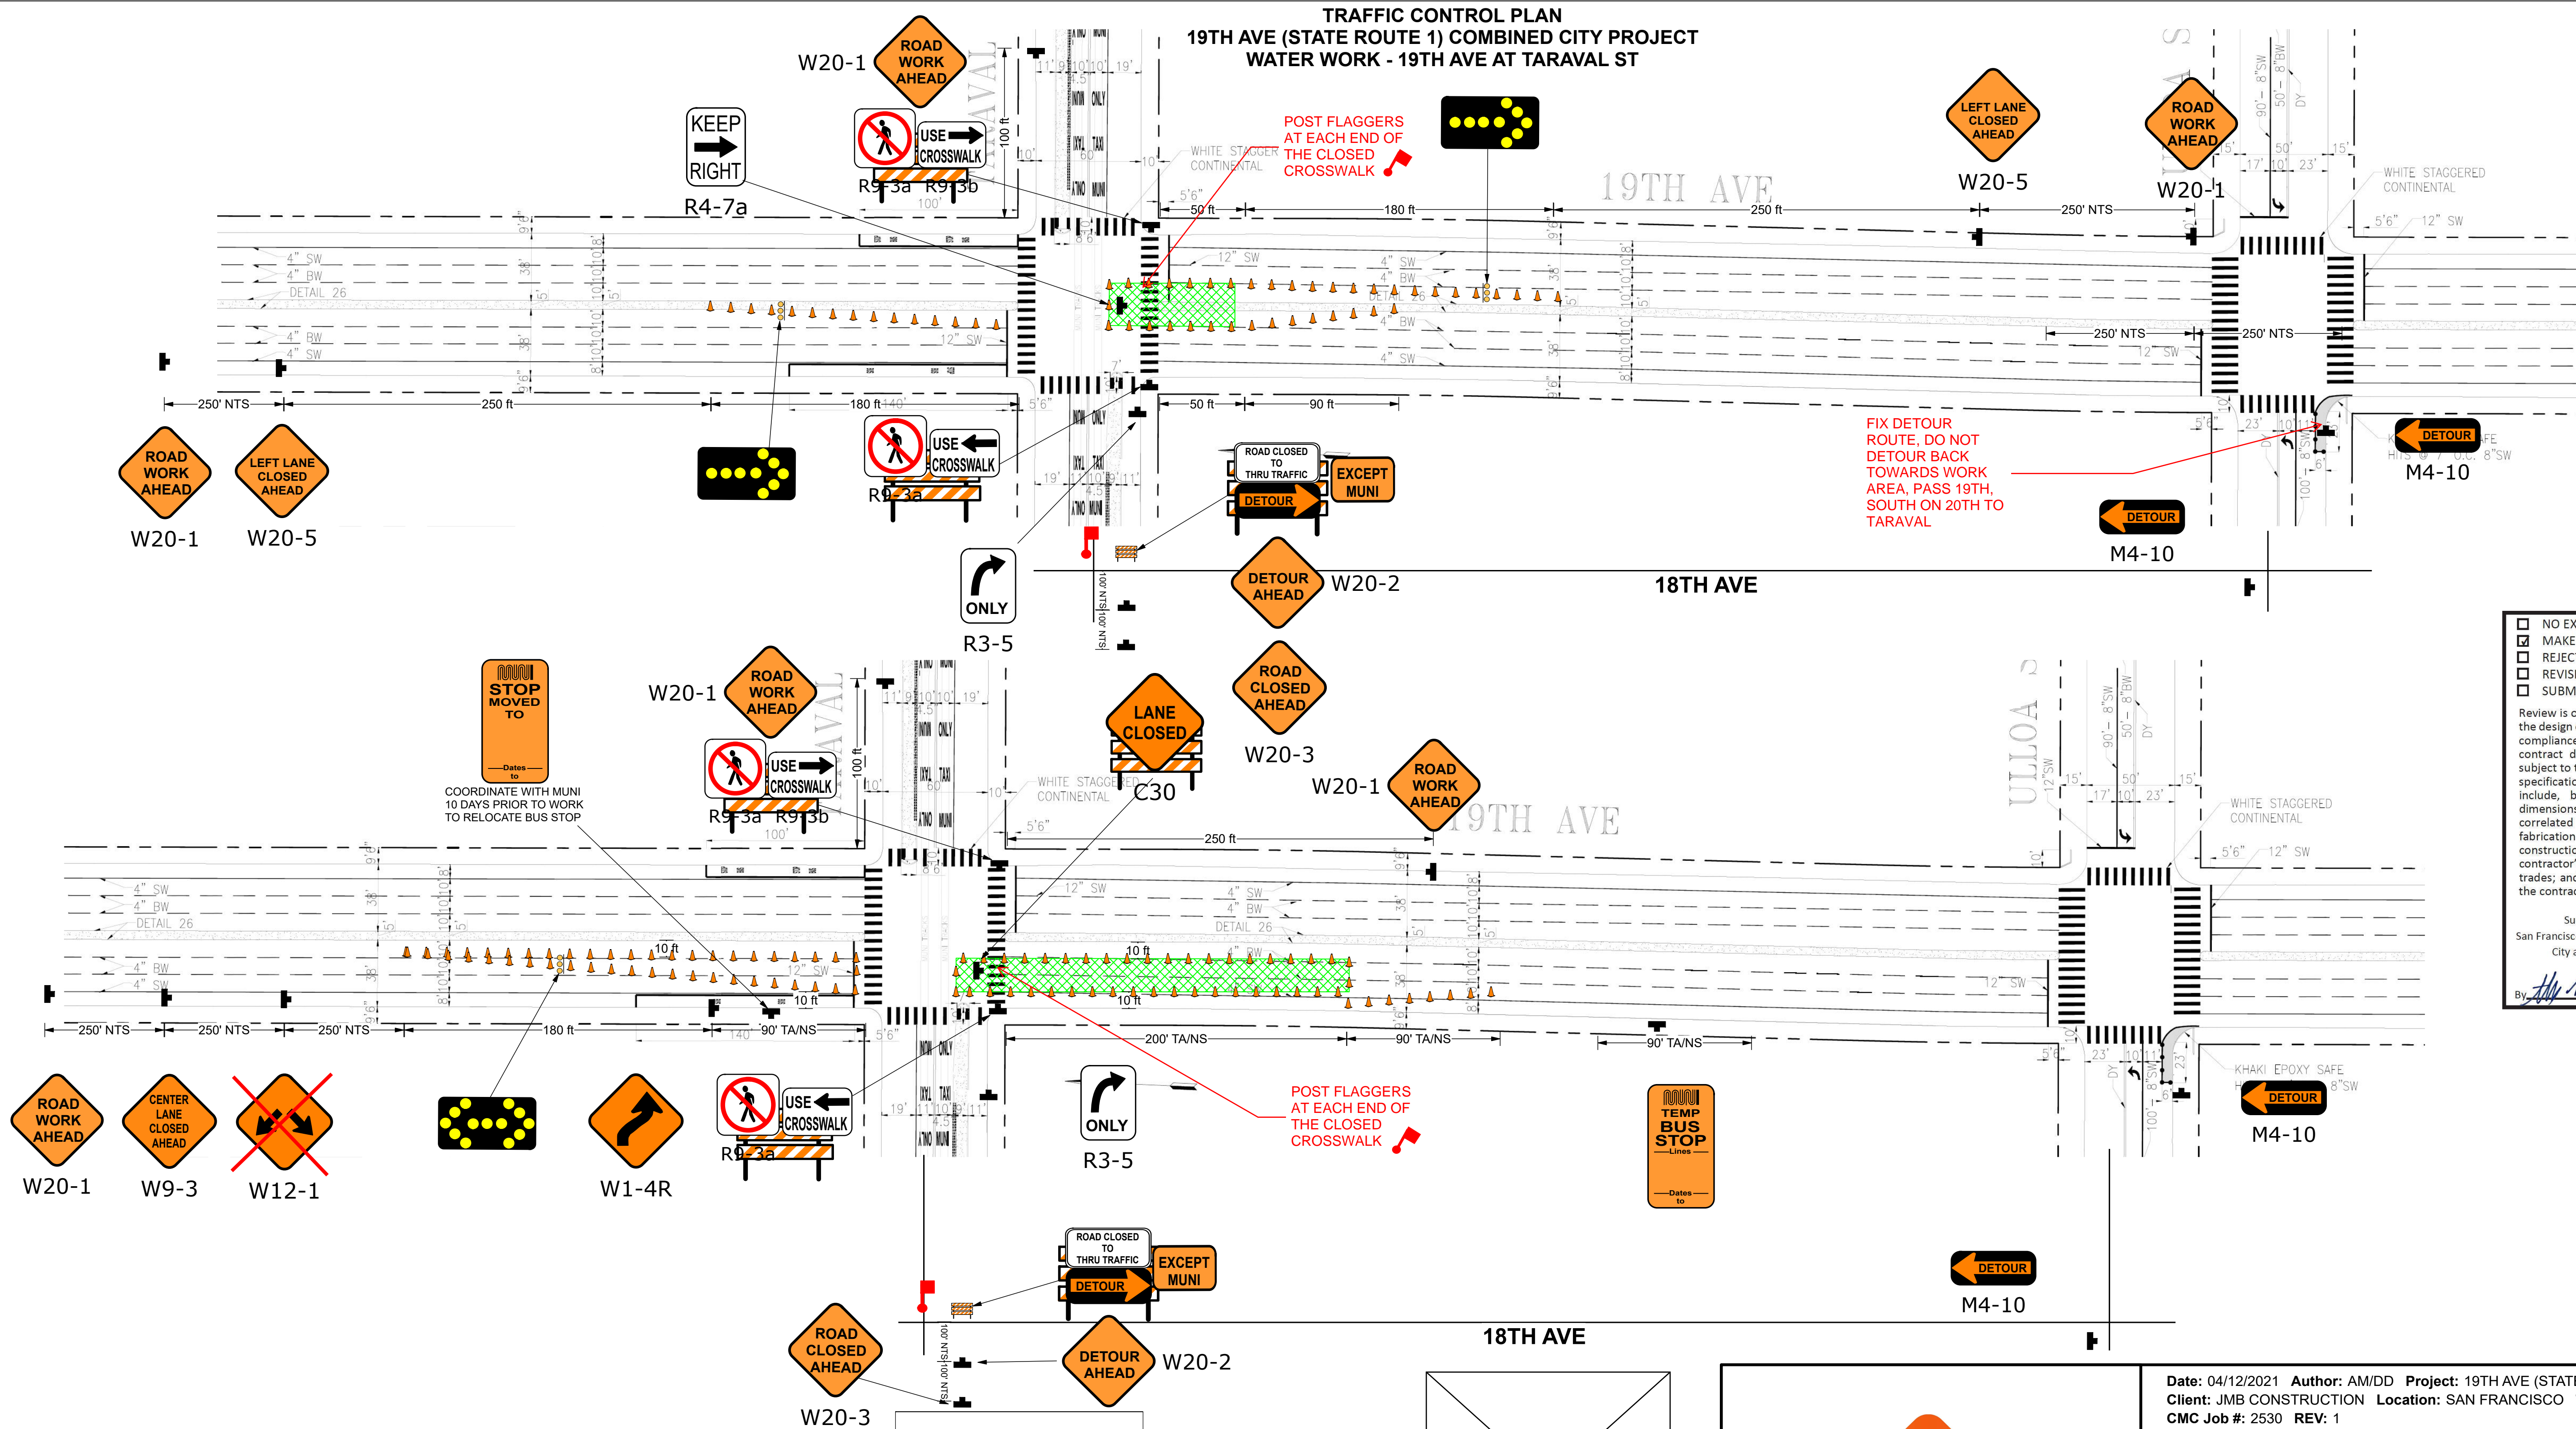

☐ NO EXCEPTIONS TAKEN
☒ MAKE CORRECTIONS NOTED
☐ REJECTED
☐ REVISE AND RESUBMIT
☐ SUBMIT SPECIFIED ITEM(S)

Review is only for general conformance with the design concept of the project and general compliance with the requirements of the contract documents. Any action shown is subject to the requirements of the plans and specifications. Contractor's responsibilities include, but are not limited to actual dimensions which shall be confirmed and correlated at the job site; preferred fabrication processes and techniques of construction; coordination of the contractor's work with that of all other trades; and the satisfactory performance of the contractor's work.

Sustainable Streets Division
San Francisco Municipal Transportation Agency
City and County of San Francisco

By *[Signature]* Date **4/16/2021**

Traffic Lane Requirements
Number and Width of Lanes for Through Traffic

STREET	TIME	NORTHBOUND	SOUTHBOUND	EASTBOUND	WESTBOUND
DURING WATER WORK (Except 36" DIP, and 16" DIP)					
19 TH AVENUE					
Vicente St. to Quintara St. *(MC)	7AM – 5PM (M-F)	2@10'	2@10'	-	-
	At All Times	Full Roadway	Full Roadway	-	-
CROSS STREETS for 19 TH AVENUE					
Taraval St. (south crossing) *(MC, MM) ★	9AM – 3PM (M-F)	-	-	Closed @ (Except Muni)	Full Roadway
	At Other Times	-	-	Full Roadway	Full Roadway
Taraval St. (north crossing) *(MC, MM) ★	9AM – 3PM (M-F)	-	-	Full Roadway	Closed @ (Except Muni)
	At Other Times	-	-	Full Roadway	Full Roadway

Legend

Type III Barricade

28" Traffic Cone

Delineator

Pedestrian Barricade

Work Area

Sign and Stand

Direction of Travel

Not To Scale

Tow-Away/No Stopping

Parking Control Officer

Flagger

Type I Barricade

Flashing Beacon

Plan Scale

1" = 50'

3450 3RD ST #3G
SAN FRANCISCO, CA 94124
415-206-1700 PHONE
415-206-1711 FAX
INFO@CMCTRAFFIC.COM

LICENSE NO 792059
CLASS A, 31, C21
WBE/SBE/LBE/DBE CERTIFIED
WWW.CMCTRAFFIC.COM

Date: 04/12/2021 Author: AM/DD Project: 19TH AVE (STATE ROUTE 1) COMBINED CITY PROJECT
Client: JMB CONSTRUCTION Location: SAN FRANCISCO TCP: 091
CMC Job #: 2530 REV: 1

- Comments:
- 1) WORK HOURS: SEE TRAFFIC LANE REQUIREMENTS TABLE
 - 2) CONTRACTOR TO VERIFY EXISTING STRIPING IS ACCURATE PRIOR TO START OF WORK.
 - 3) ALL TRAFFIC CONTROL SHALL CONFORM TO THE LATEST EDITION OF CA MUTCD.
 - 4) ALL TRAFFIC CONTROL DEVICES SHALL BE RETROREFLECTIVE IF SETUP DURING HOURS OF DARKNESS.
 - 5) MAINTAIN LOCAL ACCESS TO BUSINESSES AND RESIDENTS AT ALL TIME.
 - 6) THE CONTRACTOR SHALL NOT PREVENT OR DELAY THE OPERATION OF MASS TRANSIT VEHICLES AT ANY TIME.
 - 7) THE CONTRACTOR SHALL PERFORM THE APPROPRIATE MEASURES TO ENSURE THE SAFETY OF BICYCLISTS ON ALL STREET ON WHICH THERE IS CONSTRUCTION.
 - 8) THE CONTRACTOR WILL NEED TO POST SAN FRANCISCO POLICE OFFICERS (SFPD) AT THE INDICATED LOCATIONS.