


20% LS of AWSS Removal Work at Location No. 26
complete by end of PP 10 - September 2021

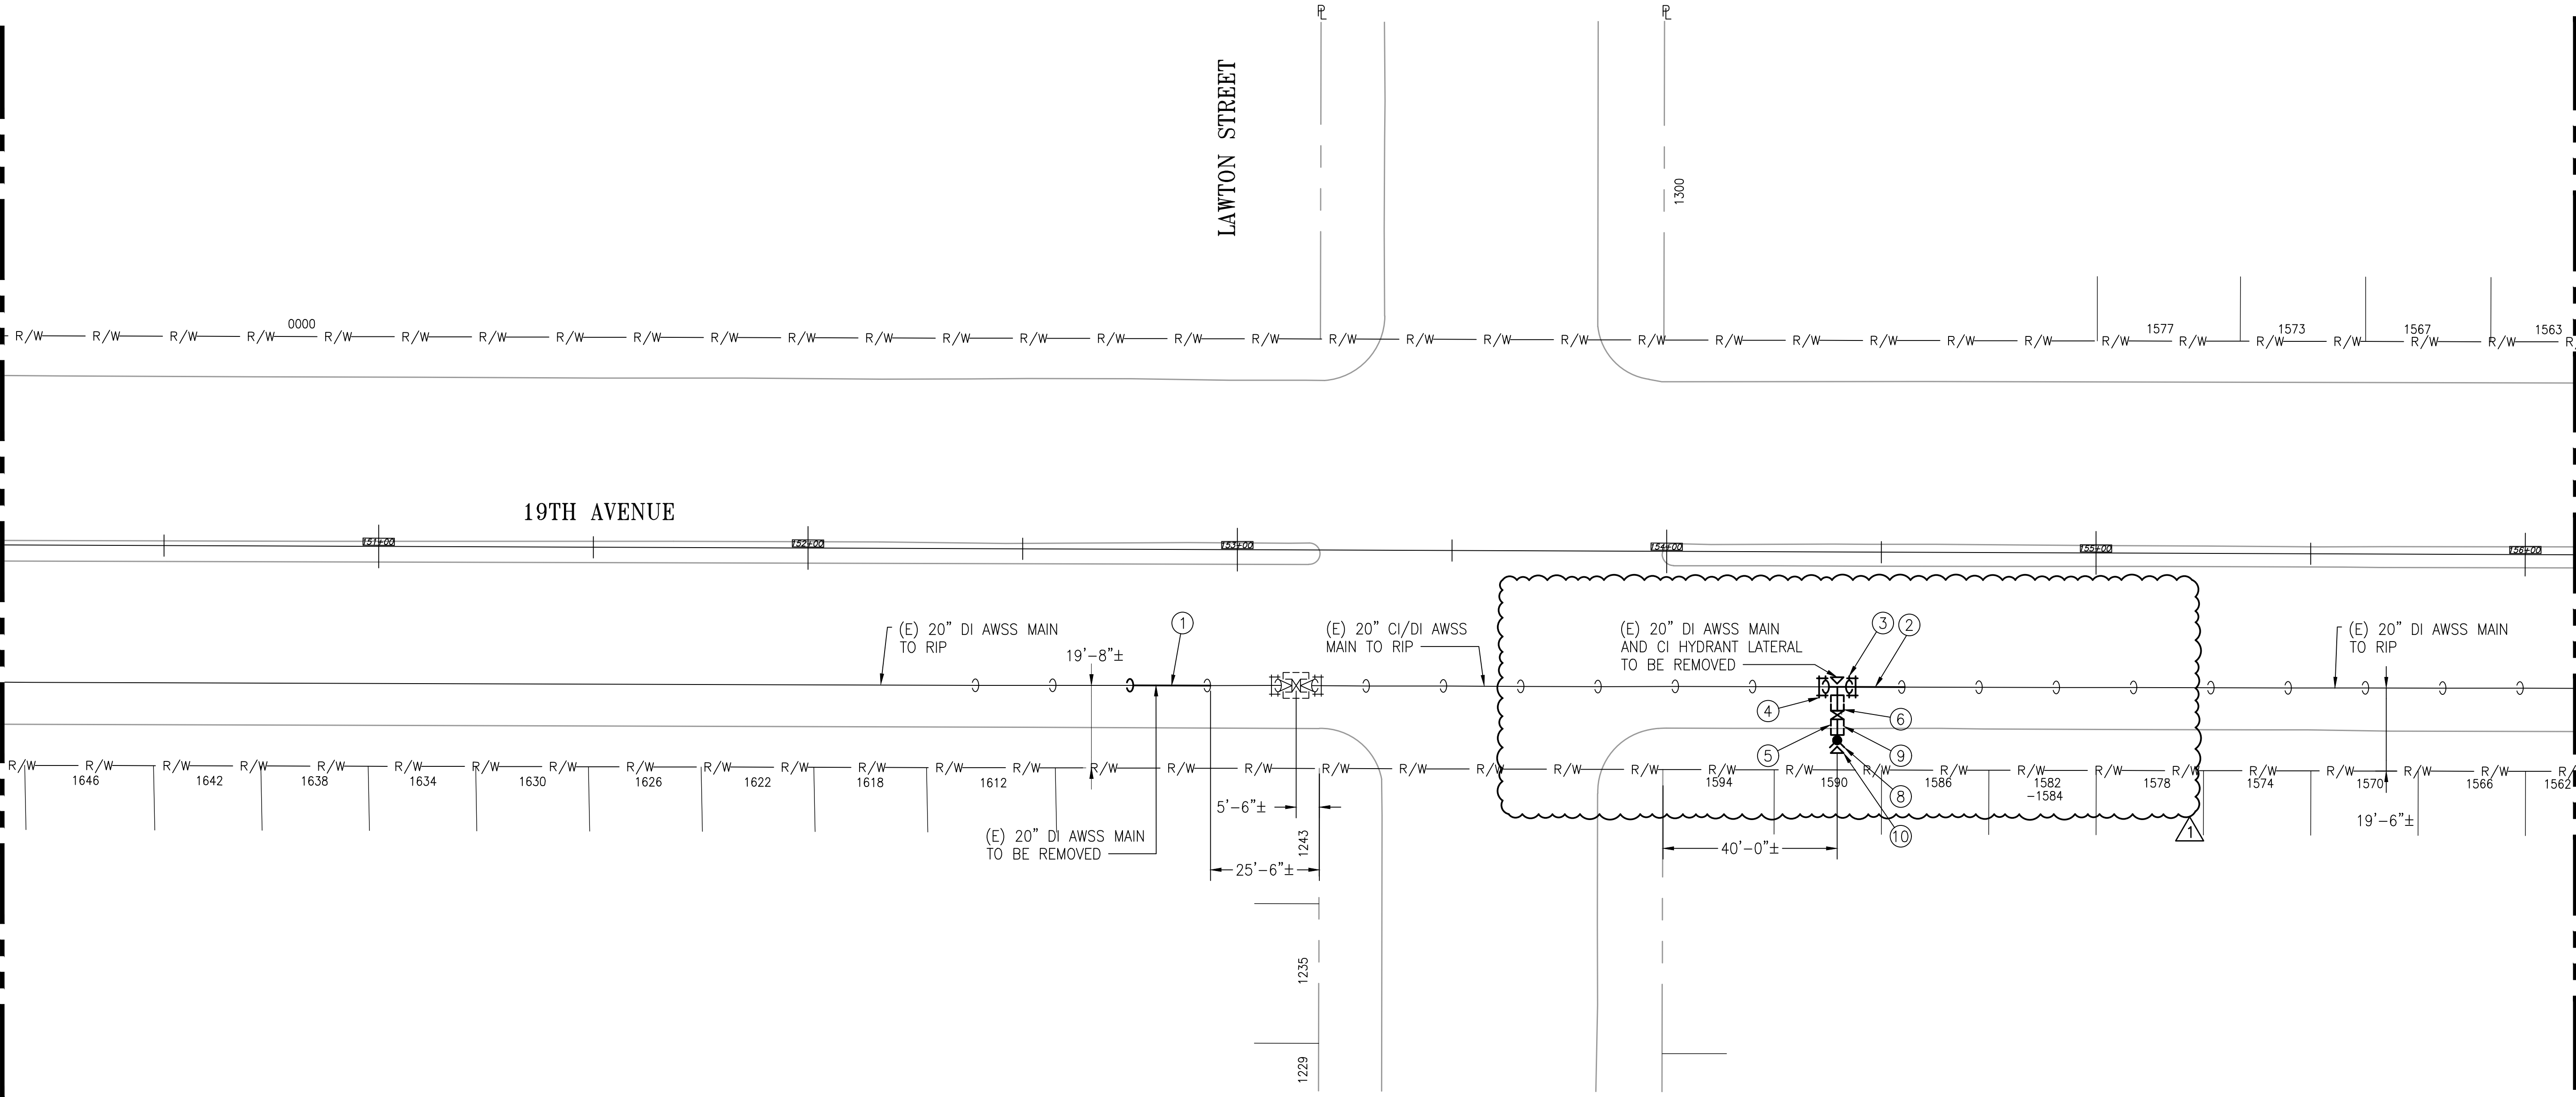

NOTES:

- REFER TO DWG MA-26.2 FOR NEW WORK PLAN.
- THE CONTRACTOR SHALL FIELD VERIFY THE EXACT DEPTHS AND LOCATIONS OF AWSS PIPES.
- REFER TO RELATED DWGS IN THIS CONTRACT PACKAGE FOR EXISTING UTILITIES ADJACENT TO THE AWSS FACILITIES TO BE REMOVED.
- REFER TO DWGS MA-G02 AND MA-G05 FOR NOTIFICATION, SCHEDULING AND SEQUENCING OF WORK.
- EXISTING PIPELINE ELEVATION FROM FINISHED STREET GRADE TO CENTERLINE OF PIPE PER RECORD DWGS AS PROVIDED BY THE SFPUC:
-20" DI PIPE ON 19TH AVENUE AT LAWTON STREET: 6'-2"± TO 7'-7"±

REMOVE AND DISPOSE AS THE CONTRACTOR'S PROPERTY (UNLESS OTHERWISE NOTED):


ITEM	QUAN	DESCRIPTION
1	8 1	20" DI BS PIPE, 18'
2	1	20" DI DS PIPE, CTS
3	1	20"x8" DI MJBxGHB HYDRANT TEE
4	2 2	20" DI STOP COLLAR (R&S)
5	2	8" CI NIPPLE, CTS
6	1	8" CI GHB GATE VALVE, VALVE BOX, FRAME, COVER, DUST PAN (R&S)
7	1	CI GHB HP HYDRANT ASSY (R&S)
8	A/R	CI HYDRANT RISER
9	A/R	STEEL/STAINLESS STEEL TIE RODS, NUTS, WASHERS
10	2	CONCRETE THRUST BLOCK

REMOVAL WORK - PLAN

SCALE: 1"=20'-0"

LOCATION 26 - 19TH AVENUE AND LAWTON STREET

PLOT: EXTENTS
SCALE: 1:1
BORDER:
22,34
COLOR: No.
RED 0.70MM
YELLOW 0.20MM
GREEN 0.25MM
CYAN 0.40MM
BLUE 0.50MM
MAGENTA 0.20MM
WHITE 0.35MM
GRAY 0.15MM
9 0.15MM
10 1.00MM
100 0.50MM
210 0.50MM

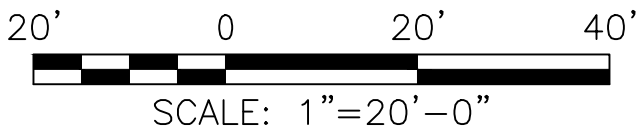

PLAN APPROVAL DATE	CONTRACT No.	PROJECT ID	DISTRICT	COUNTY	ROUTE	POST MILES TOTAL PROJECT
	04-0G3501	0400000325	04	SF	1	R0.94/4.05

FOR THE SOLE USE OF THE DOCUMENT
RECIPIENT - DO NOT CITE, COPY, OR
CIRCULATE WITHOUT THE EXPRESS
PERMISSION OF THE SFPUC.

SEE REVISION 0 DWGS
FOR SIGNATURES

REFERENCES

GATE BOOK PAGES, PLANS,
SURVEY NOTES, ETC., USED

GATE BOOK PAGES
NO.
AWSS DWG NOS. 826A,
829, 830



CITY AND COUNTY OF SAN FRANCISCO SAN FRANCISCO PUBLIC WORKS BUREAU OF DESIGN AND ENGINEERING			
SECTION MANAGER	DRAWN	MM/WC	01/2019
DEPUTY BUREAU MANAGER	DESIGNED	MBS	01/2019
BUREAU MANAGER	CHECKED	EL	01/2019
1	02/26/21	REDUCTION IN SCOPE	MBS RC
NO.	DATE	DESCRIPTION	BY APPR'D
REVISIONS			

CITY AND COUNTY OF SAN FRANCISCO PUBLIC UTILITIES COMMISSION WATER ENTERPRISE CITY DISTRIBUTION DIVISION 19TH AVENUE (STATE ROUTE 1) COMBINED CITY PROJECT AUXILIARY WATER SUPPLY SYSTEM WORK LOCATION 26 - REMOVAL WORK - PLAN			
APPROVED	APPROVED	SCALE	1"=20'-0"
ENGINEERING MANAGER	MANAGER, CITY DISTRIBUTION DIVISION	DATE	01/2019
261 OF 364	MA-26.1	FILE NO.	111,559
		REVISION NO.	1