


100% LS of AWSS Removal Work at Location No.  
26 complete by end of PP12 - November 2021;  
20% LS charged in PP10.

FILE NAME: v:\2652\19th\_avenue\_combined\_city\_project\2\_Design\working\_drawings\EME\current\awss\REV1\2652\_L\_AWSS\_MA-26.1 (REV1).dwg

SAVE: Monday, March 22, 2021 4:53:04 PM

PLOT: EXTENTS  
SCALE: 1:1  
BORDER:  
22,34  
COLOR: No.  
RED 0.70MM  
YELLOW 0.20MM  
GREEN 0.25MM  
CYAN 0.40MM  
BLUE 0.50MM  
MAGENTA 0.20MM  
WHITE 0.35MM  
GRAY 0.15MM  
9 0.15MM  
10 1.00MM  
100 0.50MM  
210 0.50MM

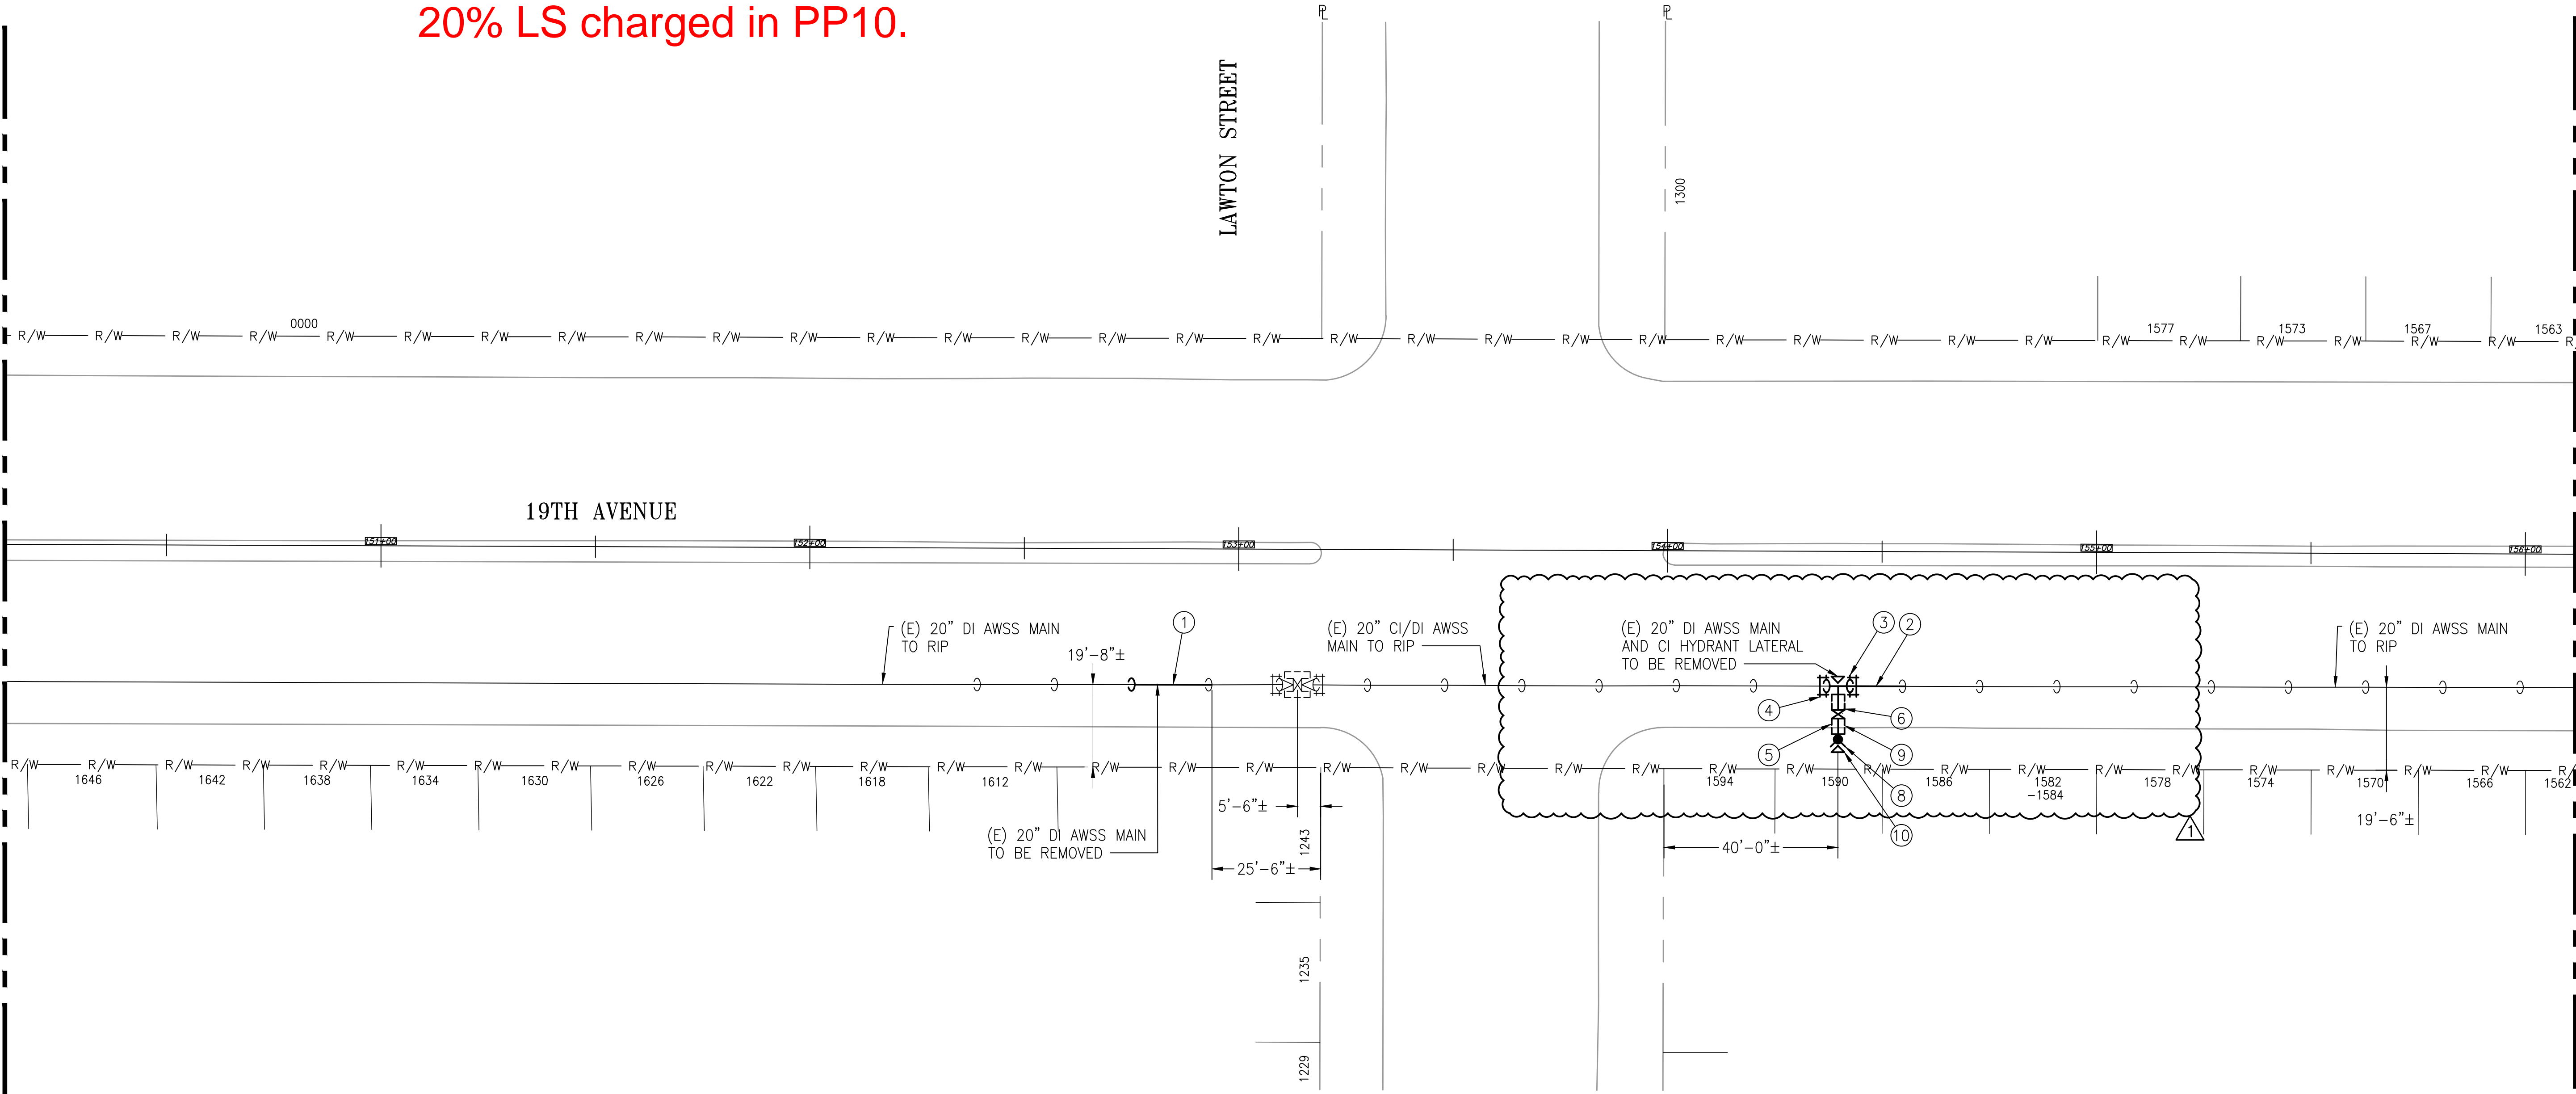

NOTES:

- REFER TO DWG MA-26.2 FOR NEW WORK PLAN.
- THE CONTRACTOR SHALL FIELD VERIFY THE EXACT DEPTHS AND LOCATIONS OF AWSS PIPES.
- REFER TO RELATED DWGS IN THIS CONTRACT PACKAGE FOR EXISTING UTILITIES ADJACENT TO THE AWSS FACILITIES TO BE REMOVED.
- REFER TO DWGS MA-G02 AND MA-G05 FOR NOTIFICATION, SCHEDULING AND SEQUENCING OF WORK.
- EXISTING PIPELINE ELEVATION FROM FINISHED STREET GRADE TO CENTERLINE OF PIPE PER RECORD DWGS AS PROVIDED BY THE SFPUC:  
-20" DI PIPE ON 19TH AVENUE AT LAWTON STREET: 6'-2"± TO 7'-7"±

REMOVE AND DISPOSE AS THE CONTRACTOR'S PROPERTY (UNLESS OTHERWISE NOTED):

ITEM	QUAN	DESCRIPTION
1	8	1 20" DI BS PIPE, 18'
2	1	20" DI DS PIPE, CTS
3	1	20"x8" DI MJBxGHB HYDRANT TEE
4	2	20" DI STOP COLLAR (R&S)
5	2	8" CI NIPPLE, CTS
6	1	8" CI GHB GATE VALVE, VALVE BOX, FRAME, COVER, DUST PAN (R&S)
7	1	CI GHB HP HYDRANT ASSY (R&S)
8	A/R	CI HYDRANT RISER
9	A/R	STEEL/STAINLESS STEEL TIE RODS, NUTS, WASHERS
10	2	CONCRETE THRUST BLOCK

FOR THE SOLE USE OF THE DOCUMENT  
RECIPIENT - DO NOT CITE, COPY, OR  
CIRCULATE WITHOUT THE EXPRESS  
PERMISSION OF THE SFPUC.

SEE REVISION 0 DWGS  
FOR SIGNATURES

REFERENCES

GATE BOOK PAGES, PLANS,  
SURVEY NOTES, ETC., USED  
  
GATE BOOK PAGES  
NO.  
AWSS DWG NOS. 826A,  
829, 830



REMOVAL WORK - PLAN  
SCALE: 1"=20'-0"

LOCATION 26 - 19TH AVENUE AND LAWTON STREET

CITY AND COUNTY OF SAN FRANCISCO SAN FRANCISCO PUBLIC WORKS BUREAU OF DESIGN AND ENGINEERING			
SECTION MANAGER	DRAWN	MM/WC	01/2019
DEPUTY BUREAU MANAGER	DESIGNED	MBS	01/2019
BUREAU MANAGER	CHECKED	EL	01/2019
1	02/26/21	REDUCTION IN SCOPE	MBS RC
NO.	DATE	DESCRIPTION	BY APPR'D
REVISIONS			

CITY AND COUNTY OF SAN FRANCISCO PUBLIC UTILITIES COMMISSION WATER ENTERPRISE CITY DISTRIBUTION DIVISION 19TH AVENUE (STATE ROUTE 1) COMBINED CITY PROJECT AUXILIARY WATER SUPPLY SYSTEM WORK LOCATION 26 - REMOVAL WORK - PLAN			
APPROVED	APPROVED	SCALE	1"=20'-0"
ENGINEERING MANAGER	MANAGER, CITY DISTRIBUTION DIVISION	DATE	01/2019
261 OF 364	MA-26.1	FILE NO.	111,559
REVISION NO.	1		

FILE:

FOR REDUCED PLANS ORIGINAL SCALE IS IN INCHES

0 1 2 3 4

MATCHLINE - SEE DWG MA-27.1

SFPW JOB ORDER NO. 26521