




TRAFFIC CONTROL PLAN
19TH AVE (STATE ROUTE 1) COMBINED CITY PROJECT
AWSS WORK - 19TH AVE AT KIRKHAM ST

- ☒ NO EXCEPTIONS TAKEN
- ☐ MAKE CORRECTIONS NOTED
- ☐ REJECTED
- ☐ REVISE AND RESUBMIT
- ☐ SUBMIT SPECIFIED ITEM(S)

Review is only for general conformance with the design concept of the project and general compliance with the requirements of the contract documents. Any action shown is subject to the requirements of the plans and specifications. Contractor's responsibilities include, but are not limited to actual dimensions which shall be confirmed and correlated at the job site; preferred fabrication processes and techniques of construction; coordination of the contractor's work with that of all other trades; and the satisfactory performance of the contractor's work.

Sustainable Streets Division
San Francisco Municipal Transportation Agency
City and County of San Francisco

By: *[Signature]* Date: 1/14/2021

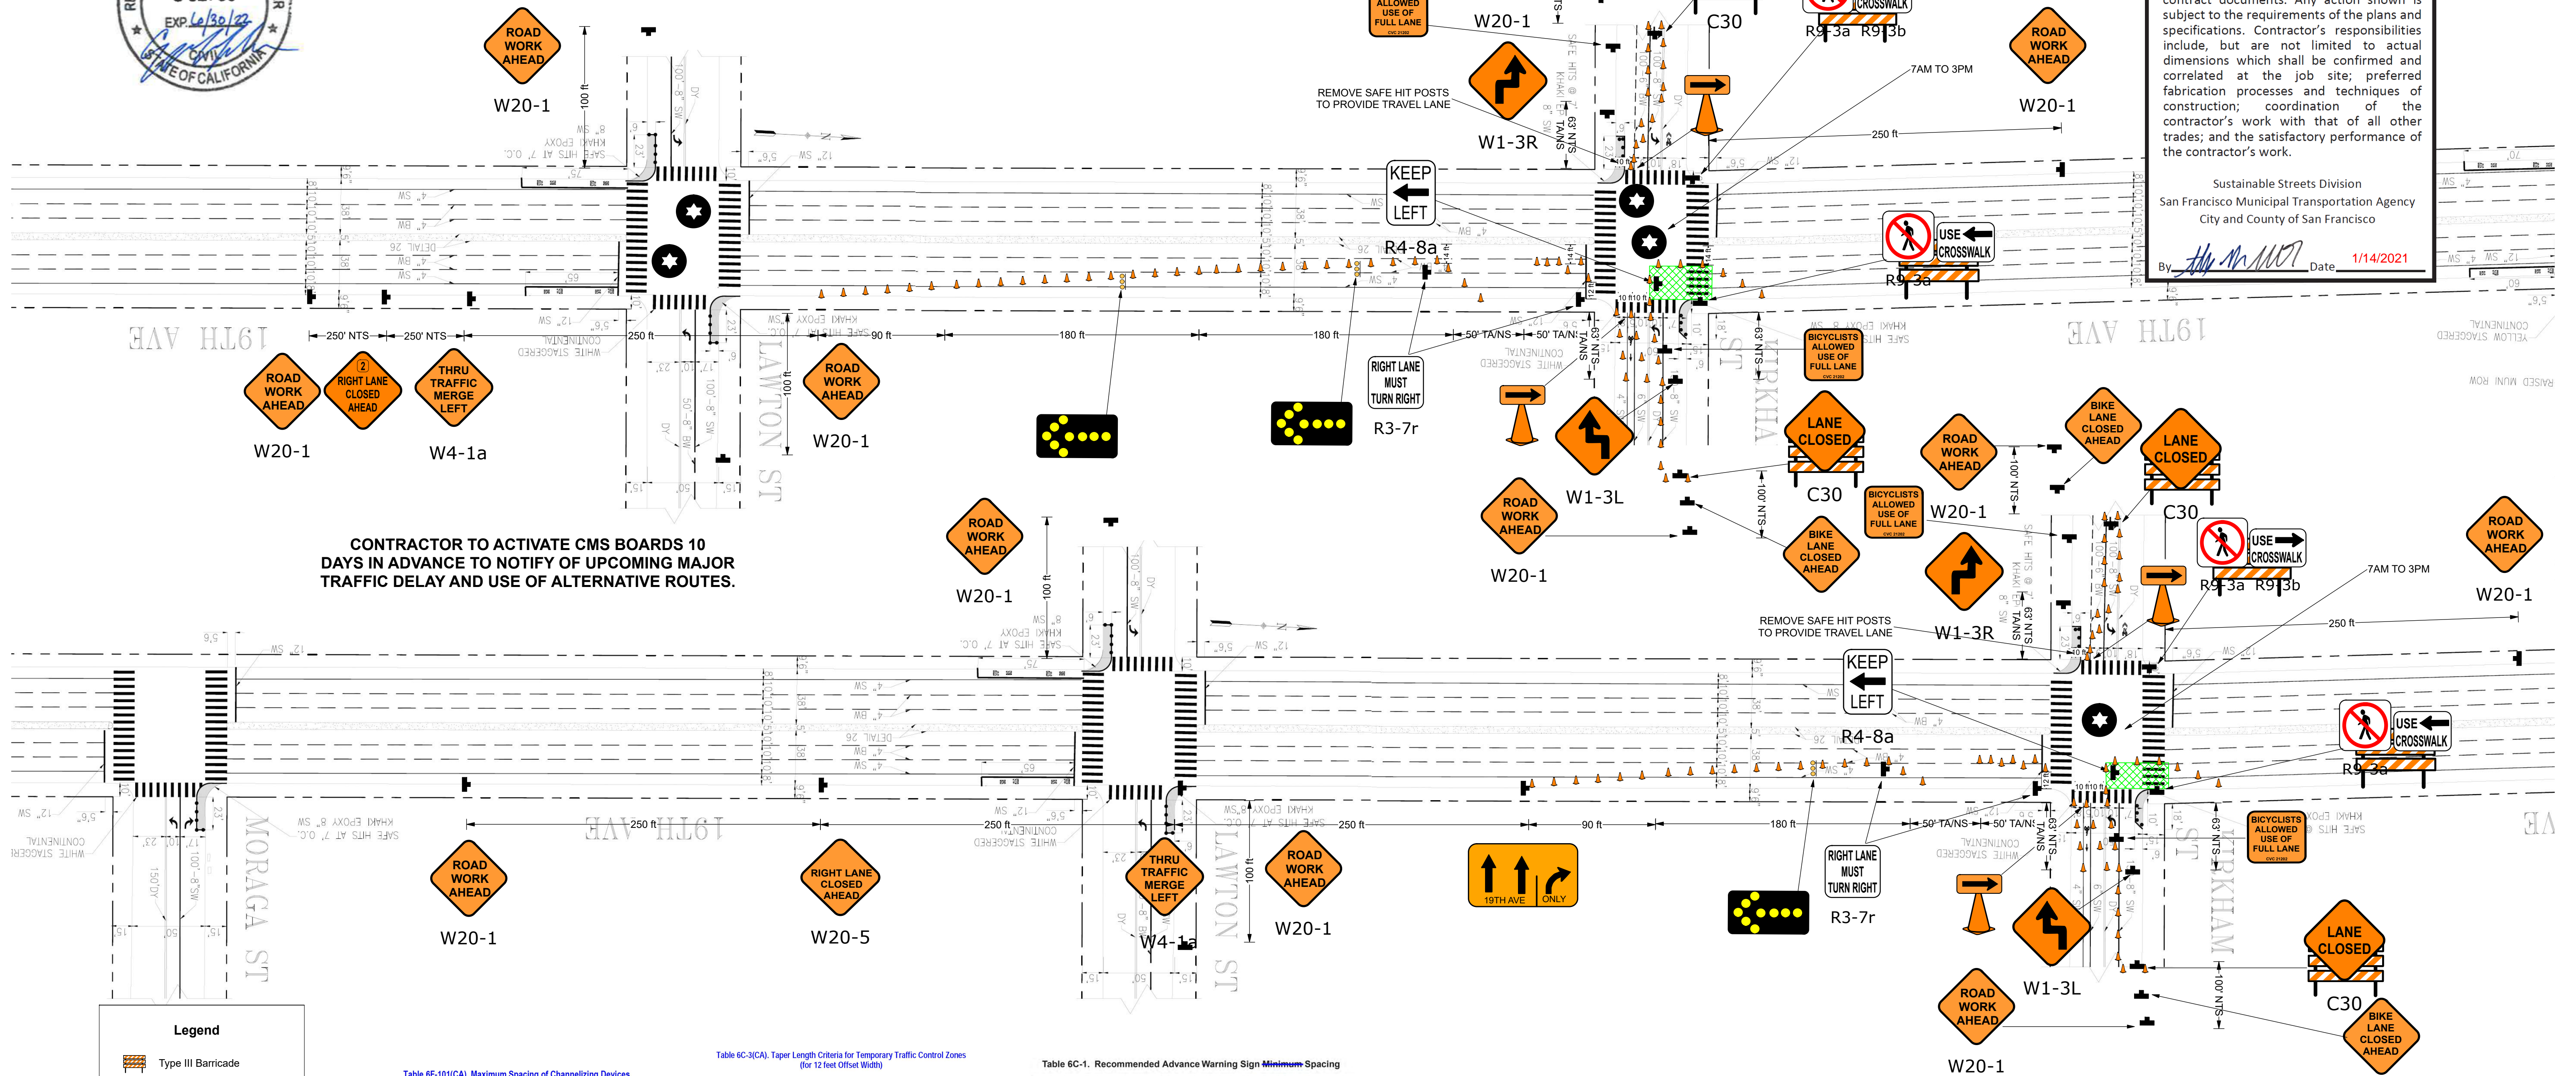

Legend	
	Type III Barricade
	28" Traffic Cone
	Delineator
	Pedestrian Barricade
	Work Area
	Sign and Stand
	Direction of Travel
	Concrete K-Rail
	Crash Cushion
	NTS Not To Scale
	TAWNS Tow-Away/No Stopping
	Parking Control Officer
	Flagger
	Type I Barricade
	Flashing Beacon

Table 6F-101(CA). Maximum Spacing of Channelizing Devices				
Speed (mph)	Taper* (feet)	Tangent (feet)	Conflict** (feet)	
20	20	40	10	
25	25	50	12	
30	30	60	15	
35	35	70	17	
40	40	80	20	
45	45	90	22	
50	50	100	25	
55	50	100	25	
60	50	100	25	
65	50	100	25	
70	50	100	25	
75	50	100	25	


* Maximum channelizing device spacing for all speeds on one-lane/two-way tapers is 20 feet.
Maximum channelizing device spacing for all speeds on downstream tapers is 20 feet.
All other tapers are as shown.
** Use on intermediate and short-term projects for taper and tangent sections where there are no pavement markings or where there is a conflict between existing pavement markings and channelizing devices.

Table 6C-3(CA). Taper Length Criteria for Temporary Traffic Control Zones (for 12 feet Offset Width)				
Speed* S (mph)	Minimum Taper Length**			
	Merging L (feet)	Shifting L/2 (feet)	Shoulder L/3 (feet)	Down Stream (feet)***
20	90	40	27	50
25	125	63	42	50
30	180	90	60	50
35	245	123	82	50
40	320	160	107	50
45	340	270	190	50
50	600	300	200	50
55	660	330	220	50
60	720	360	240	50
65	780	390	260	50
70	840	420	280	50
75	900	450	300	50

* - Posted speed limit, off-peak 85th percentile speed prior to work starting, or the anticipated operating speed in mph.
** - For other offsets use the following merging taper length formula for L:
For speeds of 40 mph or less, L=WS/160
For speeds of 45 mph or more, L=WS
Where:
L = taper length in feet
W = width of offset in feet
S = posted speed limit, off-peak 85th percentile speed prior to work starting, or the anticipated operating speed in mph
*** - Maximum downstream taper length is 100 feet. See Section 6C.08.

Road Type	Distance Between Signs**		
	A	B	C
Urban downgrades: 25 mph or less***	100 feet	100 feet	100 feet
Urban - more than 25 mph to 40 mph***	200 feet	200 feet	200 feet
Urban upgrades: more than 40 mph***	300 feet	300 feet	300 feet
Rural	500 feet	500 feet	500 feet
Expressway / Freeway	1,000 feet	1,000 feet	2,000 feet

* - Based on spacing to the first sign and the distance between signs.
** - The column headings A, B, and C are the dimensions shown in Figures 6C-1 through 6C-4. The A dimension is the distance from the transition or point of restriction to the first sign. The B dimension is the distance between the first and second signs. The C dimension is the distance between the second and third signs. (The "first sign" is the sign in a three-sign series that is closest to the TTC zone. The "third sign" is the sign that is furthest upstream from the TTC zone.)
*** - Posted speed limit, off-peak 85th percentile speed prior to work starting, or other anticipated operating speed in mph.

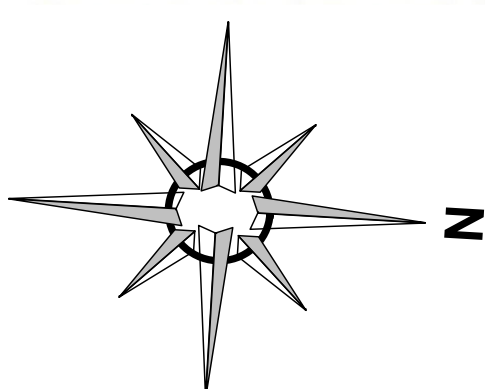

Plan Scale
1" = 55'

3450 3RD ST #3G
SAN FRANCISCO, CA 94124
415-206-1700 PHONE
415-206-1711 FAX
INFO@CMCTRAFFIC.COM

LICENSE NO 792059
CLASS A, 31, C21
WBE/SBE/LBE/DBE CERTIFIED
WWW.CMCTRAFFIC.COM

Date: 01/04/2021 Author: RC/CM Project: 19TH AVE (STATE ROUTE 1) COMBINED CITY PROJECT
Client: JMB CONSTRUCTION Location: SAN FRANCISCO TCP: 031
CMC Job #: 2530 REV: 1

Comments:
1) WORK HOURS: SEE TRAFFIC LANE REQUIREMENTS TABLE
2) CONTRACTOR TO VERIFY EXISTING STRIPING IS ACCURATE PRIOR TO START OF WORK.
3) ALL TRAFFIC CONTROL SHALL CONFORM TO THE LATEST EDITION OF CA MUTCD.
4) ALL TRAFFIC CONTROL DEVICES SHALL BE RETROREFLECTIVE IF SETUP DURING HOURS OF DARKNESS.
5) MAINTAIN LOCAL ACCESS TO BUSINESSES AND RESIDENTS AT ALL TIME.
6) THE CONTRACTOR SHALL NOT PREVENT OR DELAY THE OPERATION OF MASS TRANSIT VEHICLES AT ANY TIME.
7) THE CONTRACTOR SHALL PERFORM THE APPROPRIATE MEASURES TO ENSURE THE SAFETY OF BICYCLISTS ON ALL STREET ON WHICH THERE IS CONSTRUCTION.