


- SW-36 - Side Sewer Connection - 13 EA
- SW-37 - 6in VCP - 306 LF
- SW-39 - Vent Trap - 12 EA
- SW-41 - Post CCTV of New Side Sewer/Culvert - 13 EA

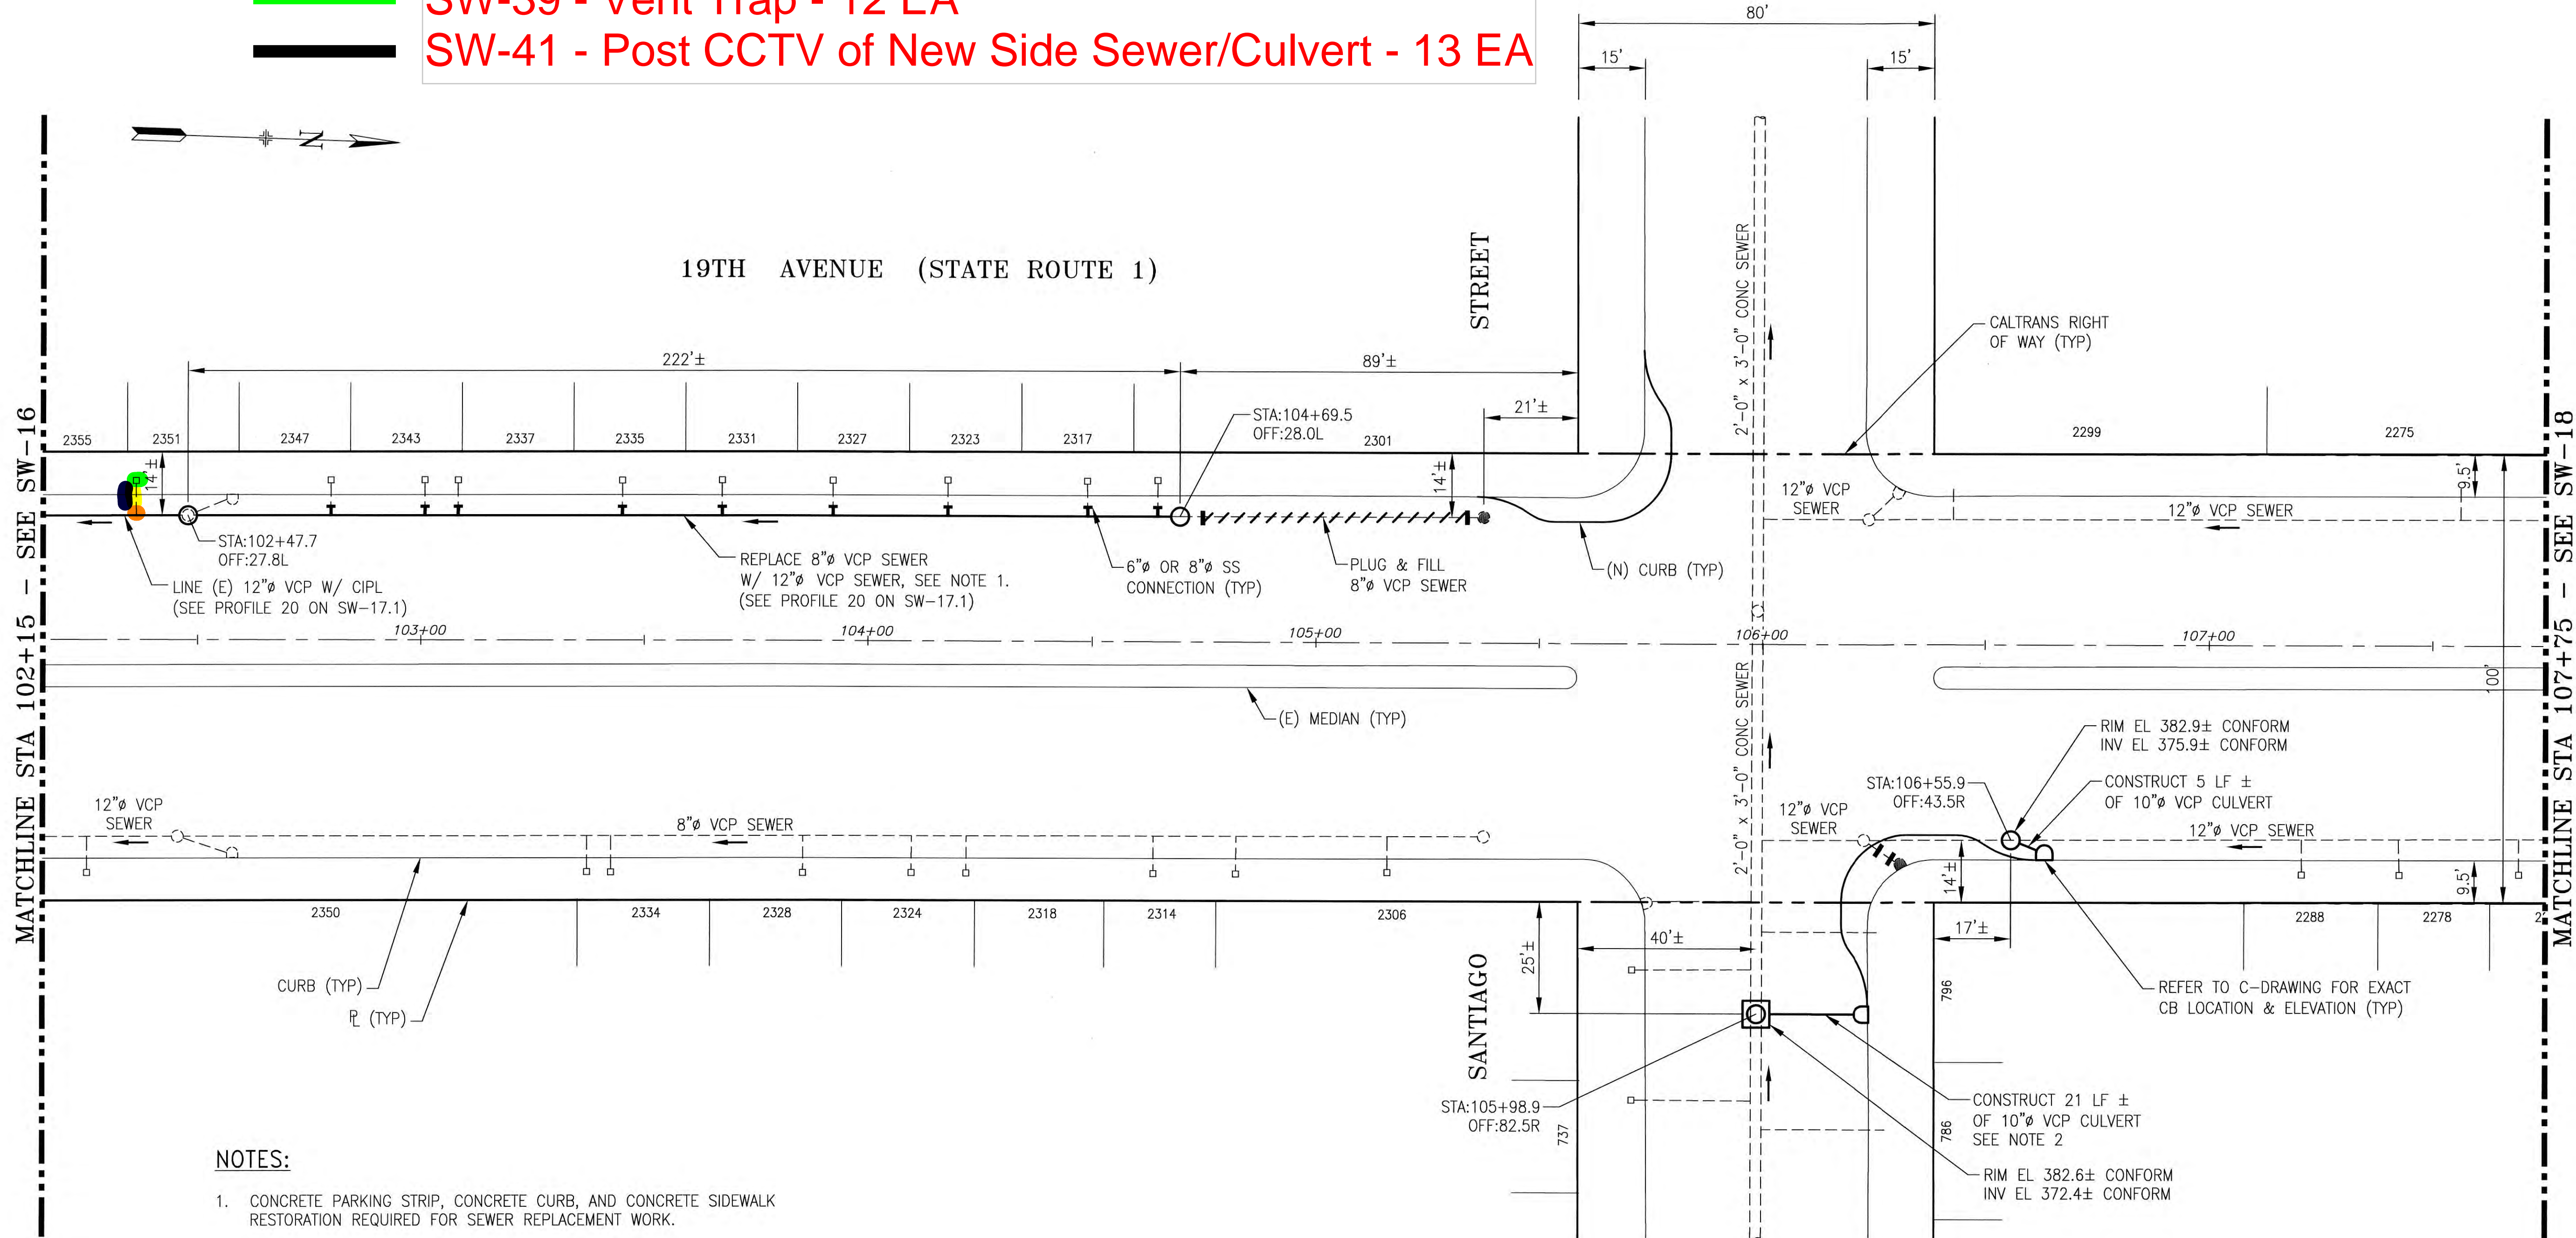

- NOTES:
- CONCRETE PARKING STRIP, CONCRETE CURB, AND CONCRETE SIDEWALK RESTORATION REQUIRED FOR SEWER REPLACEMENT WORK.
  - CONTRACTOR SHALL POTHOLE FOR EXACT LOCATION OF ELECTRICAL LINE PRIOR TO CULVERT/CB CONSTRUCTION.

PLAN  
SCALE: 1"=20'

SEWER SIZED BY  
B.S. BS  
APPROVED BY  
B.S. BS  
SCALE: 1"=20'

NO.	DATE	DESCRIPTION	BY	APP.
0	12/19	ISSUE FOR BID	BN	LW
TABLE OF REVISIONS				

REFERENCE INFORMATION & FILE NO. OF SURVEYS
A-11533 A-12822



BUREAU OF ENGINEERING  
CITY & COUNTY OF SAN FRANCISCO  
SAN FRANCISCO PUBLIC WORKS  
30 VAN NESS AVENUE, 5TH FLOOR  
SAN FRANCISCO, CA 94102 - 6028

Section Mgr: LESLEY WONG Deputy Bureau Mgr: FERNANDO CISNEROS Acting Bureau Mgr: IQBAL DHAPA	Date: 12/12/19 12/16/19 12/16/19
---	---

ELEVATION DATUM NAVD88	PLAN APPROVAL DATE	CONTRACT No.	PROJECT ID	DISTRICT	COUNTY	ROUTE	POST MILES TOTAL PROJECT
		04-0G3501	0400000325	04	SF	1	R0.94/4.05
DESIGNED: B.NG BN DRAWN: S.LIM SL CHECKED: G.FONG DATE: 12/2019	SCALE: AS SHOWN SHEET OF SHEETS 159 OF 356	19TH AVENUE (STATE ROUTE 1) COMBINED CITY PROJECT 19TH AVENUE SEWER REPLACEMENT STA 102+15 TO STA 107+75 PLAN					CONTRACT ID 1000005832 DRAWING NO. SW-17 FILE NO. 111,457 REV. NO. 0