

TRAFFIC CONTROL PLAN
19TH AVE (STATE ROUTE 1) COMBINED CITY PROJECT
AWSS WORK - 19TH AVE AT ULLOA ST


<input type="checkbox"/>	NO EXCEPTIONS TAKEN
<input checked="" type="checkbox"/>	MAKE CORRECTIONS NOTED
<input type="checkbox"/>	REJECTED
<input type="checkbox"/>	REVISE AND RESUBMIT
<input type="checkbox"/>	SUBMIT SPECIFIED ITEM(S)

Review is only for general conformance with the design concept of the project and general compliance with the requirements of the contract documents. Any action shown is subject to the requirements of the plans and specifications. Contractor's responsibilities include, but are not limited to actual dimensions which shall be confirmed and correlated at the job site; preferred fabrication processes and techniques of construction; coordination of the contractor's work with that of all other trades; and the satisfactory performance of the contractor's work.


Sustainable Streets Division
 San Francisco Municipal Transportation Agency
 City and County of San Francisco

By: *[Signature]* Date: 07/20/2021


**CONTRACTOR TO ACTIVATE CMS BOARDS 2 WEEKS
 IN ADVANCE TO NOTIFY UPCOMING MAJOR TRAFFIC
 DELAY AND USE OF ALTERNATE ROUTES**

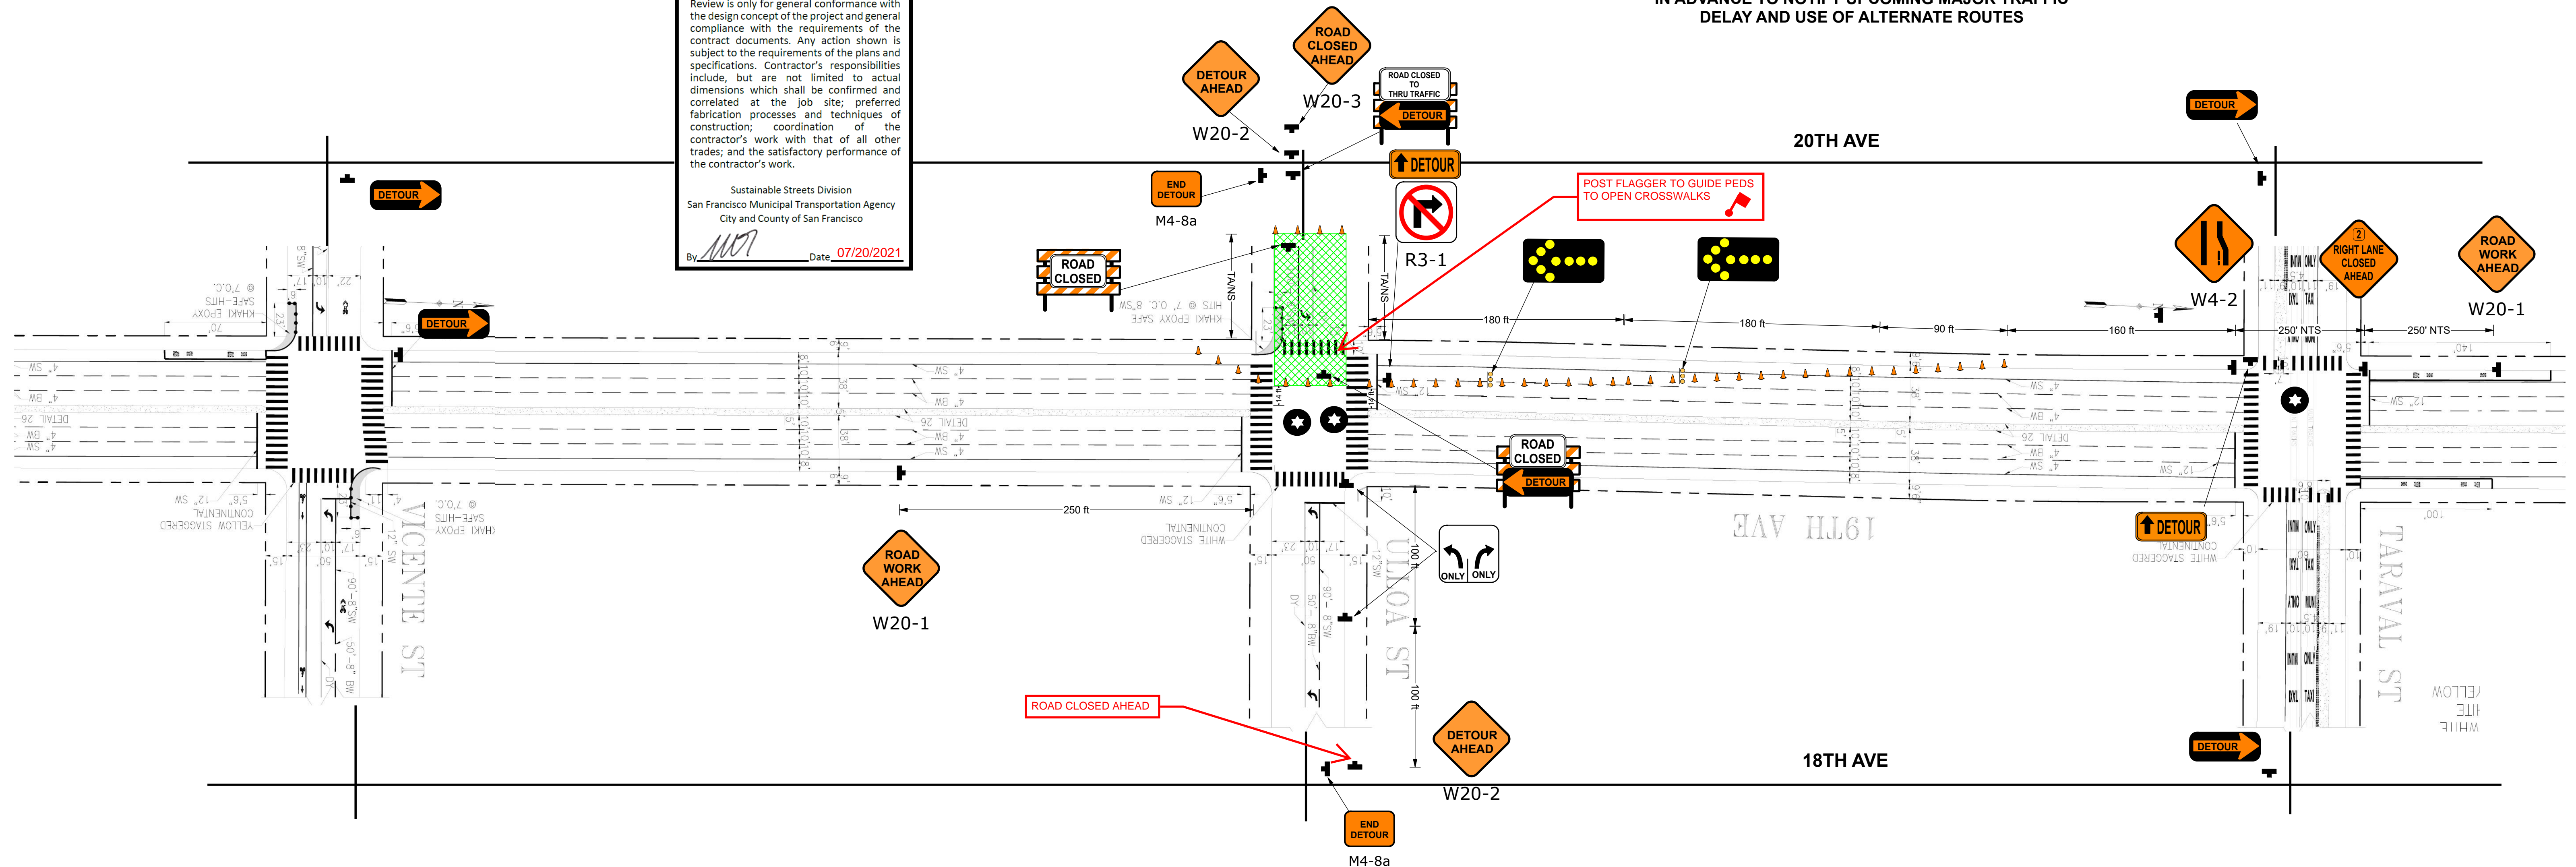

Legend

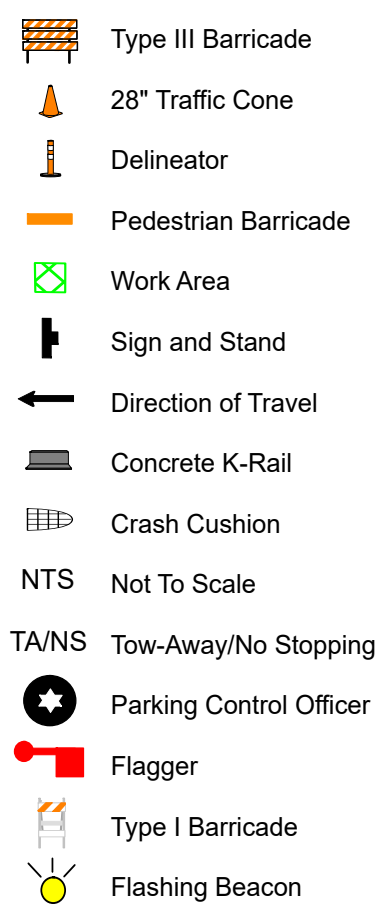

STREET	TIME	NORTHBOUND	SOUTHBOUND	EASTBOUND	WESTBOUND
DURING AWSS MONITORING, REMOVAL AND NEW WORK					
19TH AVENUE					
Vicente St. to Ulloa St. *(MC)	7AM – 5PM (M-F) removal and monitoring work	2 @ 10'	Full Roadway	-	-
	9AM – 3PM (M-F) new work	1 @ 14'	3 @ 10'		
	3PM – 5PM (M-F) new work	2 @ 10'	3 @ 10'		
	At Other Times	Full Roadway	Full Roadway		
Ulloa St. to Taraval St. *(MC)	7AM – 5PM (M-F) removal and monitoring work	2 @ 10'	Full Roadway	-	-
	9AM – 3PM (M-F) new work	3 @ 10'	1 @ 14'		
	3PM – 5PM (M-F) new work	3 @ 10'	2 @ 10'		
	At Other Times	Full Roadway	Full Roadway	-	-
CROSS STREETS for 19TH AVENUE					
Ulloa St. *	7AM – 5PM (M-F) monitoring work	-	-	1 @ 10'	1 @ 10'
	7AM – 5PM (M-F) removal and new work			Closed @ (west leg) 1 @ 10' (east leg)	1 @ 10' (east leg)
	At Other Times	-	-	Full Roadway	Full Roadway

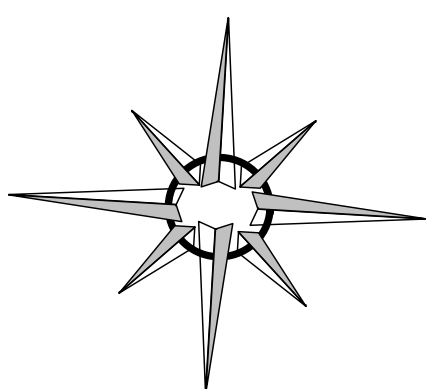

Plan Scale
 1" = 55'



3450 3RD ST #3G
 SAN FRANCISCO, CA 94124
 415-206-1700 PHONE
 415-206-1711 FAX
 INFO@CMCTRAFFIC.COM

LICENSE NO 792059
 CLASS A, 31, C21
 WBE/SBE/LBE/DBE CERTIFIED
 WWW.CMCTRAFFIC.COM

Date: 05/07/2021 **Author:** RC/CM **Project:** 19TH AVE (STATE ROUTE 1) COMBINED CITY PROJECT
Client: JMB CONSTRUCTION **Location:** SAN FRANCISCO **TCP:** 077
CMC Job #: 2530 **REV:** 1

Comments:

- 1) WORK HOURS: SEE TRAFFIC LANE REQUIREMENTS TABLE
- 2) CONTRACTOR TO VERIFY EXISTING STRIPING IS ACCURATE PRIOR TO START OF WORK.
- 3) ALL TRAFFIC CONTROL SHALL CONFORM TO THE LATEST EDITION OF CA MUTCD.
- 4) ALL TRAFFIC CONTROL DEVICES SHALL BE RETROREFLECTIVE IF SETUP DURING HOURS OF DARKNESS.
- 5) MAINTAIN LOCAL ACCESS TO BUSINESSES AND RESIDENTS AT ALL TIME.
- 6) THE CONTRACTOR SHALL NOT PREVENT OR DELAY THE OPERATION OF MASS TRANSIT VEHICLES AT ANY TIME.
- 7) THE CONTRACTOR SHALL PERFORM THE APPROPRIATE MEASURES TO ENSURE THE SAFETY OF BICYCLISTS ON ALL STREET ON WHICH THERE IS CONSTRUCTION.