

# TRAFFIC CONTROL PLAN 19TH AVE (STATE ROUTE 1) COMBINED CITY PROJECT BUS PAD WORK - 19TH AVE AT TARAVAL ST


☐ NO EXCEPTIONS TAKEN  
☒ MAKE CORRECTIONS NOTED  
☐ REJECTED  
☐ REVISE AND RESUBMIT  
☐ SUBMIT SPECIFIED ITEM(S)

Review is only for general conformance with the design concept of the project and general compliance with the requirements of the contract documents. Any action shown is subject to the requirements of the plans and specifications. Contractor's responsibilities include, but are not limited to actual dimensions which shall be confirmed and correlated at the job site; preferred fabrication processes and techniques of construction; coordination of the contractor's work with that of all other trades; and the satisfactory performance of the contractor's work.


Sustainable Streets Division  
San Francisco Municipal Transportation Agency  
City and County of San Francisco

By *[Signature]* Date **06/07/2021**

## WORKING HOURS

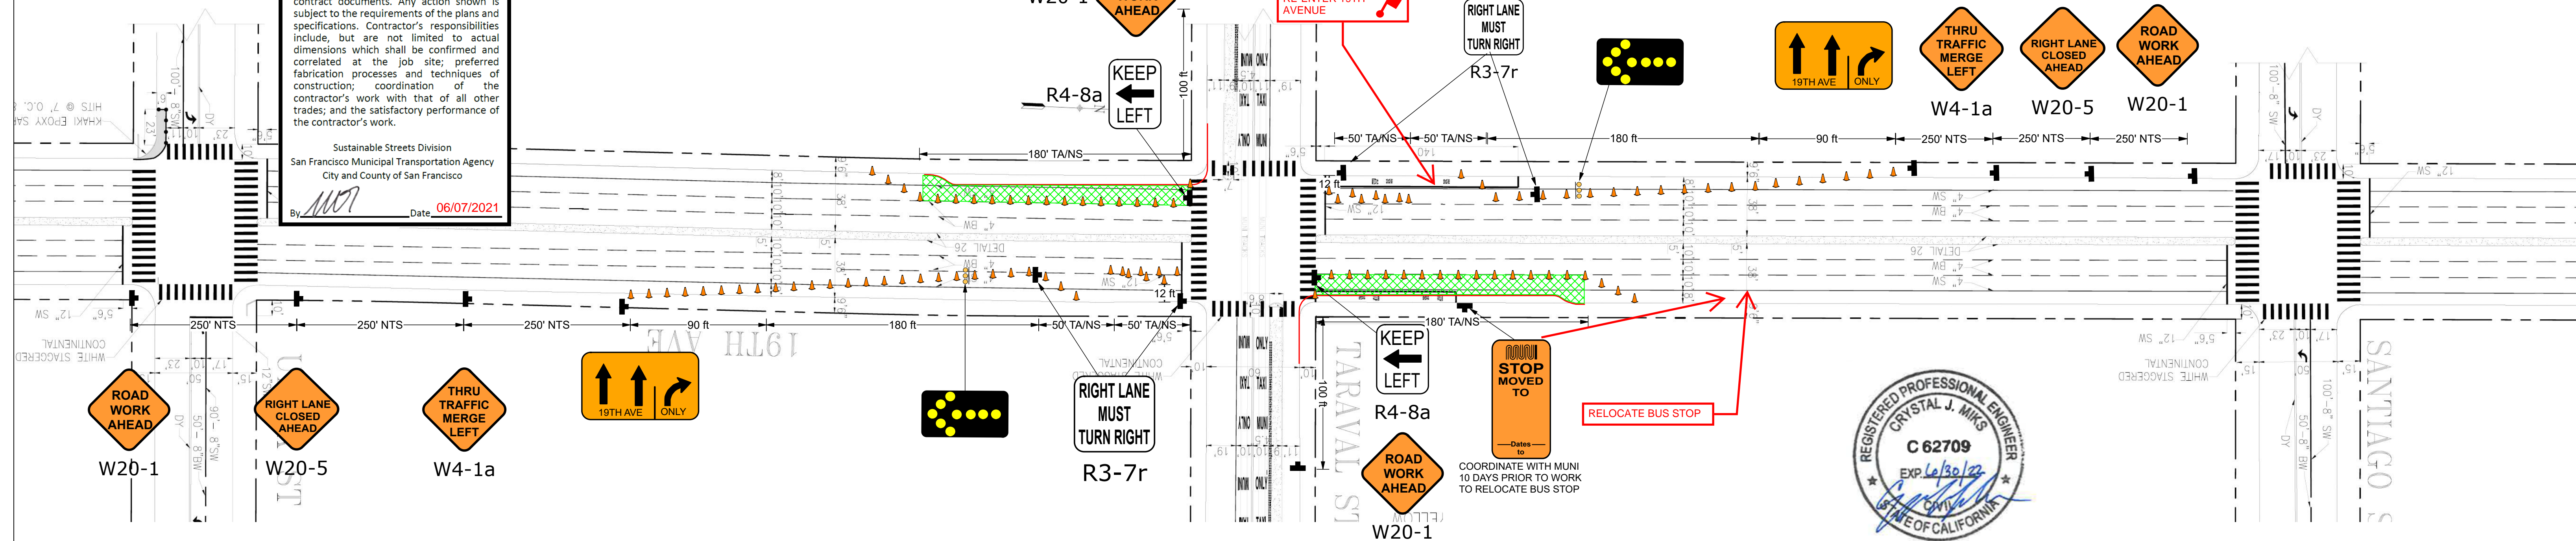

## NON-WORKING HOURS

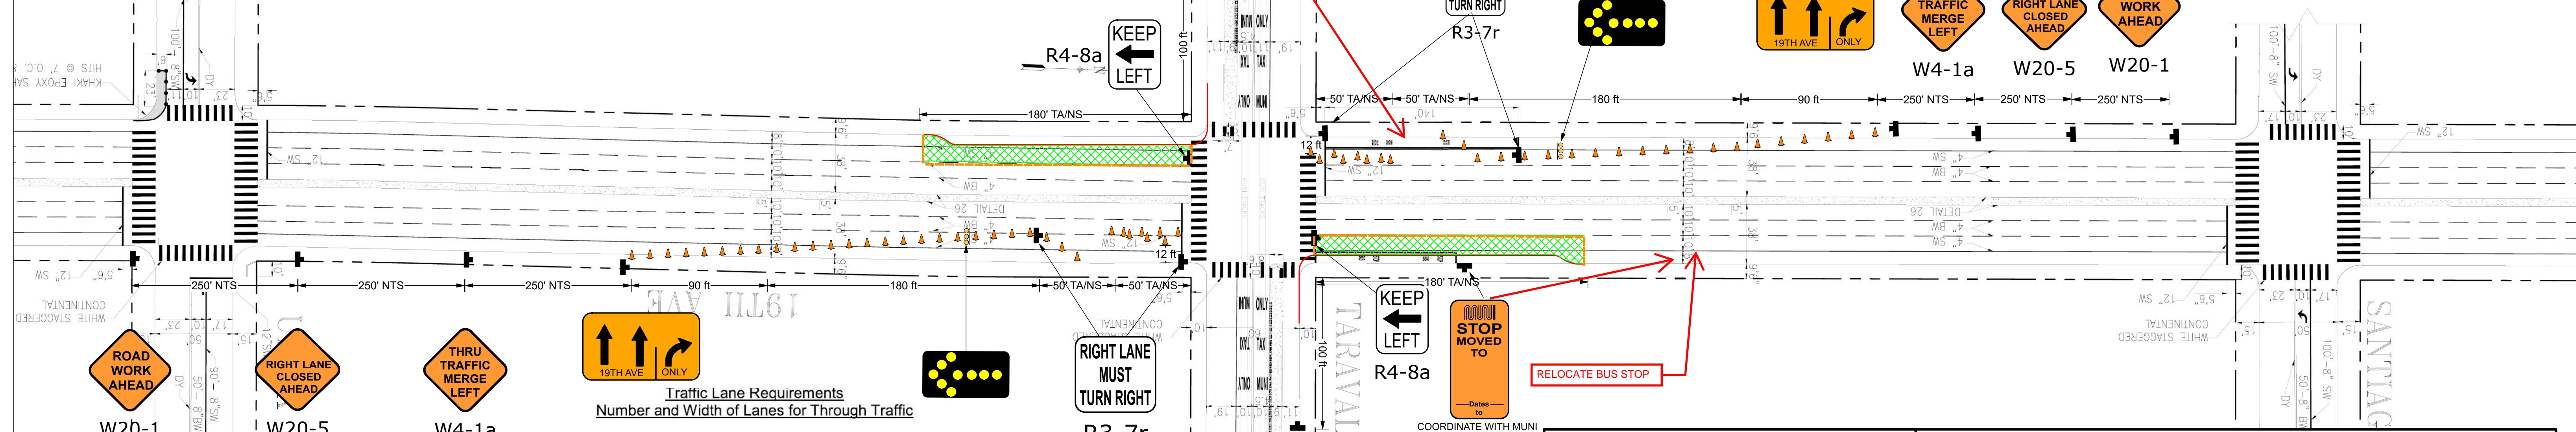


Traffic Lane Requirements  
Number and Width of Lanes for Through Traffic

STREET	TIME	NORTHBOUND	SOUTHBOUND	EASTBOUND	WESTBOUND
<b>DURING CONCRETE BUS PAD AND BASE REPAIR WORK</b>					
<b>19th Avenue and Taraval Street Intersection</b>					
19th Ave.	7AM – 5PM (M-F)	2@10'	2@10'	-	-
* (MC)	During concrete bus pad curing	2@10'	2@10'	-	-
	At Other Times	Full Roadway	Full Roadway	-	-
Taraval St.	9AM – 3PM (M-F)	-	-	Closed @ (Except Muni)	Closed @ (Except Muni)
* (MC, MM)	At Other Times	-	-	Full Roadway	Full Roadway
<b>CROSS STREETS for 19TH AVENUE</b>					
Taraval St. (south crossing)	9AM – 3PM (M-F)	-	-	Closed @ (Except Muni)	Full Roadway
* (MC, MM) ★	At Other Times	-	-	Full Roadway	Full Roadway
Taraval St. (north crossing)	9AM – 3PM (M-F)	-	-	Full Roadway	Closed @ (Except Muni)
* (MC, MM) ★	At Other Times	-	-	Full Roadway	Full Roadway

**Legend**

	Type III Barricade
	28" Traffic Cone
	Delineator
	Pedestrian Barricade
	Work Area
	Sign and Stand
	Direction of Travel
NTS	Not To Scale
T/ANS	Tow-Away/No Stopping
	Parking Control Officer
	Flagger
	Type I Barricade
	Flashing Beacon

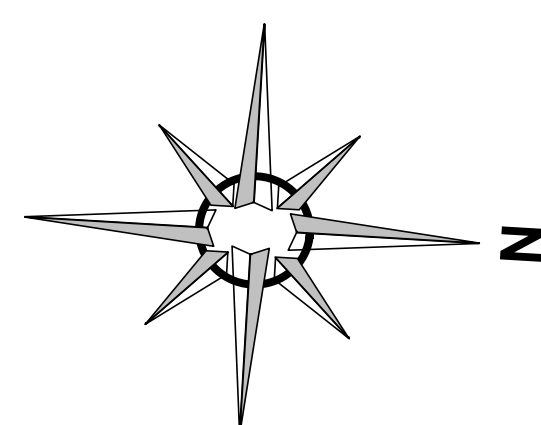

Plan Scale

1" = 50'



3450 3RD ST #3G  
SAN FRANCISCO, CA 94124  
415-206-1700 PHONE  
415-206-1711 FAX  
INFO@CMCTRAFFIC.COM

LICENSE NO 792059  
CLASS A, 31, C21  
WBE/SBE/LBE/DBE CERTIFIED  
WWW.CMCTRAFFIC.COM

Date: 06/03/2021 Author: AM/DD Project: 19TH AVE (STATE ROUTE 1) COMBINED CITY PROJECT  
Client: JMB CONSTRUCTION Location: SAN FRANCISCO TCP: 098  
CMC Job #: 2530 REV: 1

### Comments:

- 1) WORK HOURS: SEE TRAFFIC LANE REQUIREMENTS TABLE
- 2) CONTRACTOR TO VERIFY EXISTING STRIPING IS ACCURATE PRIOR TO START OF WORK.
- 3) ALL TRAFFIC CONTROL SHALL CONFORM TO THE LATEST EDITION OF CA MUTCD.
- 4) ALL TRAFFIC CONTROL DEVICES SHALL BE RETROREFLECTIVE IF SETUP DURING HOURS OF DARKNESS.
- 5) MAINTAIN LOCAL ACCESS TO BUSINESSES AND RESIDENTS AT ALL TIME.
- 6) THE CONTRACTOR SHALL NOT PREVENT OR DELAY THE OPERATION OF MASS TRANSIT VEHICLES AT ANY TIME.
- 7) THE CONTRACTOR SHALL PERFORM THE APPROPRIATE MEASURES TO ENSURE THE SAFETY OF BICYCLISTS ON ALL STREET ON WHICH THERE IS CONSTRUCTION.
- 8) THE CONTRACTOR SHALL NOTIFY MUNI AT LEAST 10 WORKING DAYS IN ADVANCE ABOUT CLOSING ANY BUS STOP AND FINALIZE LOCATION OF NEW TEMPORARY BUS STOP.
- 9) THE CONTRACTOR WILL NEED TO POST SAN FRANCISCO POLICE OFFICERS (SFPD) AT THE INDICATED LOCATIONS.